

CARD MUST BE TYPED

State of Kansas
NOTICE OF INTENTION TO DRILL
(see rules on reverse side)

CORRECTION
Amended 7-11-85
CARD MUST BE SIGNED

Starting Date: July 13, 1985
month day year

API Number 15- 095-21,533 - 0000

OPERATOR: License # 5348
Name Robert E. Campbell
Address 260 N. Rock Rd., Suite 110
City/State/Zip Wichita, KS 67206
Contact Person Robert E. Campbell
Phone (316) 685-6001

* C NE NE Sec 25 Twp 28 S, Rge 7 East West
(location)

* 4620 Ft North from Southeast Corner of Section
* 660 Ft West from Southeast Corner of Section
(Note: Locate well on Section Plat on reverse side)

CONTRACTOR: License # 5107
Name H-30, Inc.
City/State Wichita, KS

Nearest lease or unit boundary line 660 feet.
County Kingman
Lease Name Schwartz Well# 1

Well Drilled For: Well Class: Type Equipment:
 Oil Swd Infield Mud Rotary
 Gas Inj Pool Ext. Air Rotary
 OWWO Expl Wildcat Cable

Domestic well within 330 feet: yes no
Municipal well within one mile: yes no

If OWWO: old well info as follows:

Operator
Well Name
Comp Date Old Total Depth
Projected Total Depth 2150 feet
Projected Formation at TD Indian Cave
Expected Producing Formations Indian Cave

Depth to Bottom of fresh water 100 feet
Lowest usable water formation Harper Sandstone
Depth to Bottom of usable water 200 feet
Surface pipe by Alternate: 1 2
Surface pipe to be set 225± feet
Conductor pipe if any required feet
Ground surface elevation 1562 feet MSL
This Authorization Expires 12-28-85
Approved By 6-28-85

I certify that we will comply with K.S.A. 55-101, et seq., plus eventually plugging hole to K.C.C. specifications. WRS, SE NENE 4290 FSL

Date 7-10-85 Signature of Operator or Agent

Albrigail A. White Title Agent

330FGL


RECEIVED

STATE CORPORATION COMMISSION

Must be filed with the K.C.C. five (5) days prior to commencing well
This card void if drilling not started within six (6) months of date received by K.C.C.

JUL 10 1985

CONSERVATION DIVISION
Wichita, Kansas
A Regular Section of Land
1 Mile = 5,280 Ft.

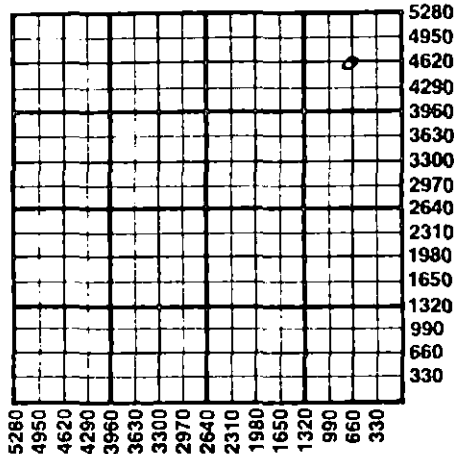

Important procedures to follow :

1. Notify District office before setting surface casing.
2. Set surface casing by circulating cement to the top.
3. File completion forms ACO-1 with K.C.C. within 90 days of well completion, following instructions on ACO-1, side 1, and including copies of wireline logs.
4. Notify District office 48 hours prior to old well workover or re-entry.
5. Prior to plugging, prepare a plugging plan, then obtain agreement from the appropriate district office for an approved plugging plan.
6. Submit plugging report (CP-4) to K.C.C. after plugging is completed.
7. Obtain an approved injection docket number before disposing of salt water.
8. Notify K.C.C. within 10 days when injection commences or terminates.
9. If an alternate 2 completion, cement in the production pipe from below any usable water to surface within 120 days of spud date.

State Corporation Commission of Kansas
Conservation Division
200 Colorado Derby Building
Wichita, Kansas 67202
(316) 263-3238