

CARD MUST BE TYPED

State of Kansas

CARD MUST BE SIGNED

NOTICE OF INTENTION TO DRILL

(O W W O)

(see rules on reverse side)

Starting Date June 20, 1986 month day year

API Number 15-095-01,005-0001

OPERATOR: License # 5601
Name Associated Petroleum Consultants, Inc.
Address Suite 602 One Main Place
City/State/Zip Wichita, Kansas 67202-1399
Contact Person Phyllis Buchanan
Phone (316)265-9385

— East
C... NW... NW... Sec. 20... Twp... 28... S, Rg... 6... X West
4620 Ft. from South Line of Section
4620 Ft. from East Line of Section

(Note: Locate well on Section Plat on reverse side)

CONTRACTOR: License # 5867
Name Heartland Drilling, Inc.
City/State Suite 602 One Main Place, Wichita, Ks

Nearest lease or unit boundary line 660 feet
County Kingman
Lease Name DYE Well # 2

Well Drilled For: Well Class: Type Equipment:
Oil SWD Infield Mud Rotary
X Gas Inj Pool Ext Air Rotary
A OWWO Expl Wildcat Cable

Ground surface elevation feet MSL
Domestic well within 330 feet: yes X no
Municipal well within one mile: yes X no

If OWWO: old well info as follows:
Operator Rains & Williamson Oil Co.
Well Name #1 Greenleaf
Comp Date 2/23/66 Old Total Depth 4382

Depth to bottom of fresh water 100
Depth to bottom of usable water 160 200
Surface pipe by Alternate: 1 X 2
Surface pipe planned to be set 267' - Pipe already set.
Conductor pipe required
Projected Total Depth 3900 feet
Formation Mississippi

I certify that well will comply with K.S.A. 55-101, et seq., plus eventually plugging hole to KCC specifications.

Date May 26, 1986 Signature of Operator or Agent Charles R. King Title President

For KCC Use:

Conductor Pipe Required feet; Minimum Surface Pipe Required 200 feet per Alt. 1

This Authorization Expires 11-27-86 Approved By 5-27-86


Handwritten signature and initials

Must be filed with the K.C.C. five (5) days prior to commencing well
This card void if drilling not started within six (6) months of date received by K.C.C.

Important procedures to follow:

1. Notify District office before setting surface casing.
2. Set surface casing by circulating cement to the top.
3. File completion forms ACO-1 with K.C.C. within 90 days of well completion, following instructions on ACO-1, side 1, and including copies of wireline logs.
4. Notify District office 48 hours prior to old well workover or re-entry.
5. Prior to filing Intent, prepare a proposed plugging plan in case well is D & A, then obtain approval of plan when calling district office prior to setting surface pipe.
6. Submit plugging report (CP-4) to K.C.C. after plugging is completed.
7. Obtain an approved injection docket number before disposing of salt water.
8. Notify K.C.C. within 10 days when injection commences or terminates.
9. If an alternate 2 completion, cement in the production pipe from below any usable water to surface within 120 days of spud date.

A Regular Section of Land 1 Mile = 5,280 Ft.

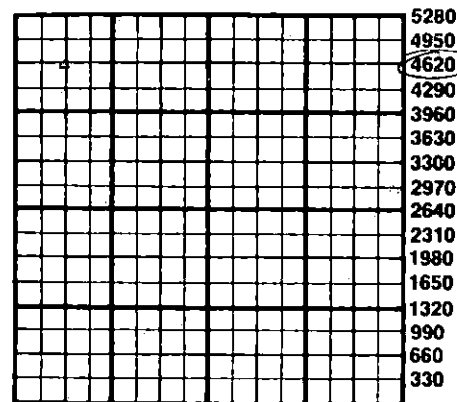

RECEIVED
STATE CORPORATION COMMISSION

MAY 27 1986

CONSERVATION DIVISION
Wichita, Kansas

State Corporation Commission of Kansas
Conservation Division
200 Colorado Derby Building
Wichita, Kansas 67202
(316) 263-3238