

FOR KCC USE:

FORM C-1 7/91

FORM MUST BE TYPED

FORM MUST BE SIGNED

ALL BLANKS MUST BE FILLED

EFFECTIVE DATE: 11-9-96

State of Kansas

DISTRICT # 2

NOTICE OF INTENTION TO DRILL

SGA? Yes No

Must be approved by the K.C.C. five (5) days prior to commencing well.

Expected Spud Date .. October 14 .. 1996 ..
month day year

Spot East
E/2- SE-SSW. Sec 11. Twp 27... S, Rg 10W. X West

OPERATOR: License # 31739
Name: Inka Carmi DEVELOPMENT LLC
Address: P.O. Box 847
City/State/Zip: Pratt, KS 67124
Contact Person: Ken Gates
Phone: 316.672.2531

660 feet from South ~~North~~ line of Section
2310 feet from East ~~West~~ line of Section
IS SECTION X REGULAR IRREGULAR?

(NOTE: Locate well on the Section Plat on Reverse Side)

County: Kingman

Lease Name: Wingate Well #: 1

Field Name: Dresden

Is this a Prorated/Spaced Field? ... yes no

Target Formation(s): Viola

Nearest lease or unit boundary: 330 ft.

Ground Surface Elevation: 1750 top of ... feet MSL

Water well within one-quarter mile: yes no

Public water supply well within one mile: yes no

Depth to bottom of fresh water: 180

Depth to bottom of usable water: 200

Surface Pipe by Alternate: 1 224 ft

Length of Surface Pipe Planned to be set: 224 ft

Length of Conductor pipe required:

Projected Total Depth: 4300 ft

Formation at Total Depth: Viola

Water Source for Drilling Operations:

well farm pond other

(APPLY FOR FROM DWR)

Will Cores Be Taken? yes no

If yes, proposed zone:

Well Drilled For:	Well Class:	Type Equipment:
<input checked="" type="checkbox"/> Oil	<input type="checkbox"/> Enh Rec	<input type="checkbox"/> Infield <input type="checkbox"/> Mud Rotary
<input checked="" type="checkbox"/> Gas	<input type="checkbox"/> Storage	<input type="checkbox"/> Pool Ext. <input type="checkbox"/> Air Rotary
<input checked="" type="checkbox"/> OWWO	<input type="checkbox"/> Disposal	<input type="checkbox"/> Wildcat <input type="checkbox"/> Cable
<input type="checkbox"/> Seismic;	<input type="checkbox"/> # of Holes	<input type="checkbox"/> Other
<input type="checkbox"/> Other		

If OWWO: old well information as follows:
Operator: W. B. Gladis W. H. GADDIS
Well Name: # 1 Shannon
Comp. Date: 5/29/40 Old Total Depth: 4315 ft

Directional, Deviated or Horizontal wellbore? ... yes no
If yes, true vertical depth:

AFFIDAVIT

RECEIVED
KANSAS CORPORATION COMMISSION

OCT 08 1996

The undersigned hereby affirms that the drilling, completion and eventual plugging of this well will comply with K.S.A. 55-101, et. seq.

It is agreed that the following minimum requirements will be met:

1. Notify the appropriate district office prior to spudding of well;
2. A copy of the approved notice of intent to drill shall be posted on each drilling rig;
3. The minimum amount of surface pipe as specified below shall be set by circulating cement to the top; in all cases surface pipe shall be set through all unconsolidated materials plus a minimum of 20 feet into the underlying formation;
4. If the well is dry hole, an agreement between the operator and the district office on plug length and placement is necessary prior to plugging;
5. The appropriate district office will be notified before well is either plugged or production casing is cemented in;
6. IF AN ALTERNATE II COMPLETION, PRODUCTION PIPE SHALL BE CEMENTED FROM BELOW ANY USABLE WATER TO SURFACE WITHIN 120 DAYS OF SPUD DATE. IN ALL CASES, NOTIFY DISTRICT OFFICE PRIOR TO ANY CEMENTING.

I hereby certify that the statements made herein are true and to the best of my knowledge and belief.

Date: 10/8/96 Signature of Operator or Agent: Leigh Raymond Title: Exploration Manager

FOR KCC USE:
 API # 15- 095-010220001
 Conductor pipe required NONE feet
 Minimum surface pipe required 224 feet per Alt.
 Approved by: JK 11-4-96
 This authorization expires: 5-4-97
 (This authorization void if drilling not started within 6 months of effective date.)
 Spud date: _____ Agent: _____

- REMEMBER TO:
- File Drill Pit Application (form CDP-1) with Intent to Drill;
 - File Completion Form ACO-1 within 120 days of spud date;
 - File acreage attribution plat according to field proration orders;
 - Notify appropriate district office 48 hours prior to workover or re-entry;
 - Submit plugging report (CP-4) after plugging is completed;
 - Obtain written approval before disposing or injecting salt water.

Mail to: KCC - Conservation Division, 130 S. Market - Room 2078, Wichita, Kansas 67202.

11
87
1003

IN ALL CASES PLOT THE INTENDED WELL ON THE PLAT BELOW

PLAT OF ACREAGE ATTRIBUTABLE TO A WELL IN A PRORATED OR SPACED FIELD



If the intended well is in a prorated or spaced field, please fully complete this side of the form. If the intended well is in a prorated or spaced field complete the plat below showing that the well will be properly located in relationship to other wells producing from the common source of supply. Please show all the wells within 1 mile of the boundaries of the proposed acreage attribution unit for gas wells and within 1/2 mile of the boundaries of the proposed acreage attribution unit for oil wells.

API NO. 15- _____
 OPERATOR Tuka Comm. Development LLC LOCATION OF WELL: COUNTY KINGMAN
 LEASE Wingate 660 feet from south/north line of section
 WELL NUMBER 1 2310 feet from east/west line of section
 FIELD Oresden SECTION 11 TWP 27 RG 10w

NUMBER OF ACRES ATTRIBUTABLE TO WELL _____ IS SECTION X REGULAR or _____ IRREGULAR
 QTR/QTR/QTR OF ACREAGE _____ IF SECTION IS IRREGULAR, LOCATE WELL FROM NEAREST
CORNER BOUNDARY.

Section corner used: _____ NE _____ NW _____ SE _____ SW
PLAT

(Show location of the well and shade attributable acreage for prorated or spaced wells.)
 (Show footage to the nearest lease or unit boundary line.)

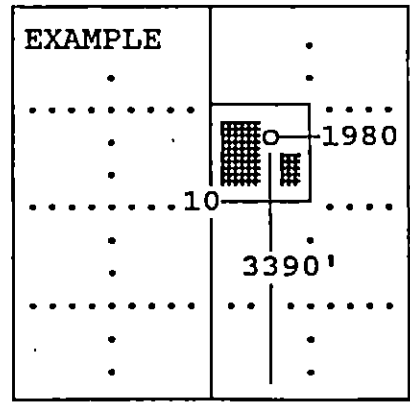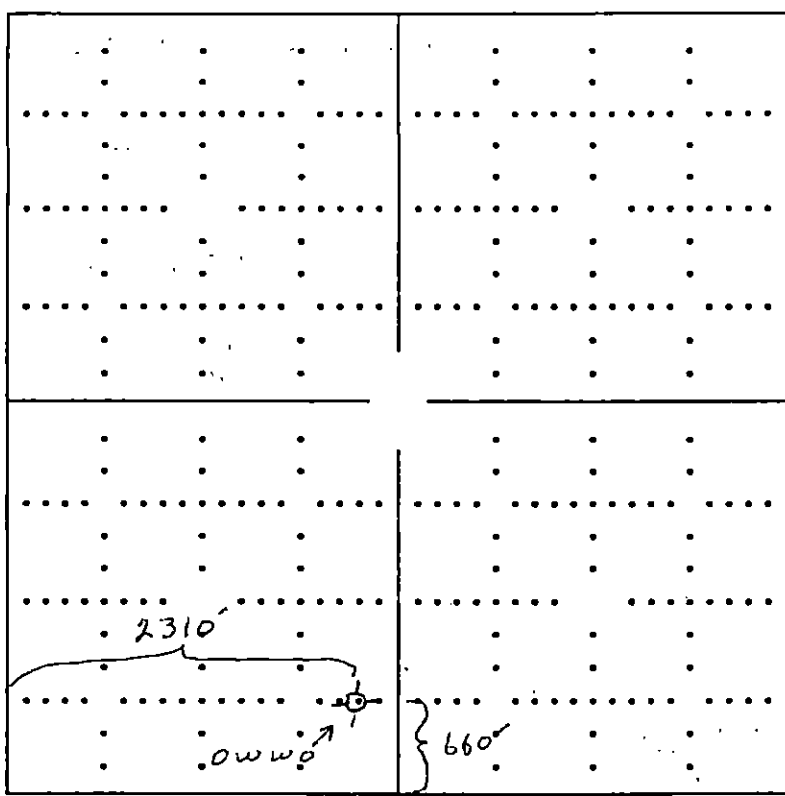

SEWARD CO.

In plotting the proposed location of the well, you must show:

- 1) The manner in which you are using the depicted plat by identifying section lines, i.e. 1 section, 1 section with 8 surrounding sections, 4 sections, etc.;
- 2) the distance of the proposed drilling location from the section's south/north and east/west; and
- 3) the distance to the nearest lease or unit boundary line.