

STATE OF KANSAS
STATE CORPORATION COMMISSION

15-095-20776-0000

WELL PLUGGING RECORD

Give All Information Completely
Make Required Affidavit
Mail or Deliver Report to
Conservation Division
State Corporation Comm.
245 North Water
Wichita, KS 67202

Kingman County, Sec. 33 Twp. 28S Rge. 8W E44
Location as "NE/CNW $\frac{1}{4}$ SW $\frac{1}{4}$ " or footage from lines _____


C-NE SE
Lease Owner Keener Oil Company
Lease Name Anna Keller Well No. 3
Office Address 406 National Bank of Tulsa Bldg., Tulsa, OK
Character of Well (Completed as Oil, Gas or Dry Hole) Dry Hole 74103

Date Well completed November 10, 1978
Application for plugging filed Verbal Application 19
Application for plugging approved Verbal Approval 19
Plugging commenced November 10, 1978
Plugging completed November 10, 1978
Reason for abandonment of well or producing formation _____

If a producing well is abandoned, date of last production _____ 19____

Was permission obtained from the Conservation Division or its agents before plugging was commenced? Yes

Name of Conservation Agent who supervised plugging of this well Wm. T. Owen
Producing formation _____ Depth to top _____ Bottom _____ Total Depth of Well 4,181'
Show depth and thickness of all water, oil and gas formations.

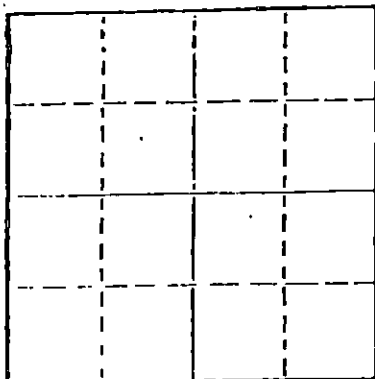

Locate well correctly on above Section Plat

OIL, GAS OR WATER RECORDS

CASING RECORD

FORMATION	CONTENT	FROM	TO	SIZE	PUT IN	PULLED OUT
				8-5/8"	213'	None

Describe in detail the manner in which the well was plugged, indicating where the mud fluid was placed and the method or methods used in introducing it into the hold. If cement or other plugs were used, state the character of same and depth placed, from _____ feet to _____ feet for each plug set.

Filled hole with heavy rotary mud from 4,181 ft. (rotary total depth) to 420 ft. Set plug at 420 ft. and cemented with 40 sacks cement. Filled hole with heavy rotary mud from 420 ft. to 210 ft. Set plug at 210 ft. and cemented with 35 sacks cement. Filled hole with heavy rotary mud from 210 ft. to 40 ft. Set solid plug at 40 ft. and cemented to cellar with 12 sacks cement, 3 sacks cement in rat hole.

Plugging operations accomplished utilizing Halliburton Serv. Oil Well cementing pump truck through 4 1/2 inch drill pipe.

(If additional description is necessary, use BACK of this sheet)


Name of Plugging Contractor Halliburton Services
410 Union Center Bldg., Wichita, Kansas 67202

STATE OF Kansas COUNTY OF Sedgwick, ss.
Dean Britting, Agent of owner ~~XXXXXXXXXXXXXXXXXXXX~~

of the above-described well, being first duly sworn on oath, says: That I have knowledge of the facts, statements, and matters herein contained and the log of the above-described well as filed and that the same are true and correct. So help me God.

(Signature) Dean Britting
200 N. Main, Wichita, Kansas 67202
(Address)

SUBSCRIBED AND SWORN TO before me this 15th day of November, 1978

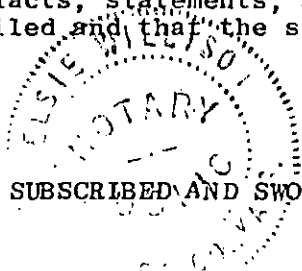

Elsie Willison
Notary Public.
STATE CORPORATION COMMISSION

My commission expires July 25, 1982

NOV 16 1978
11-16-1978
CONSERVATION DIVISION
Wichita, Kansas

KANSAS DRILLERS LOG

COMPANY Keener Oil Company

SEC. 33 T. 28S R. 8W
LOC. C-NE SE

FARM Anna Keller NO. 3

COUNTY Kingman

ROTARY TOTAL DEPTH 4,181'

COMM. November 1, 1978

COMP. November 10, 1978

CONTRACTOR H-30, Inc. (Rig #11)

ISSUED November 15, 1978

CASING

10 3/4"

8 5/8" Set at 213' cemented w/200 sxs cement

ELEVATION 1,571' K.L.B.

5 1/2"

4 1/2"

FIGURES INDICATE BOTTOM OF FORMATIONS

Shale, Sand and Red Bed	213'
Red Bed	440'
Red Bed and Shale	1,100'
Shale	1,255'
Lime and Shale	1,557'
Shale and Lime	1,805'
Shale	2,015'
Lime and Shale	2,810'
Shale and Lime	3,184'
Lime and Shale	3,385'
Shale and Lime	3,535'
Lime	4,181'
Rotary Total Depth	4,181'

I hereby certify the above and foregoing to be a true and correct log of the above described well as shown by the drilling reports.

H-30, Inc.

Dean Britting
Dean Britting

State of Kansas)
County of Sedgwick) ss:

Subscribed and Sworn to before me a Notary Public in and for said county and state this 15th day of November, 1978.



Elsie Willison
Elsie Willison - Notary Public

My Commission Expires:
July 25, 1982

RECEIVED
STATE CORPORATION OF

NOV 16 1978

CONSERVATION DIV.
Wichita, Kansas