


15095-20557-0000

STATE OF KANSAS
STATE CORPORATION COMMISSION
CONSERVATION DIVISION
P. O. BOX 17027
WICHITA, KANSAS 67217

FORM CP-4

WELL PLUGGING RECORD

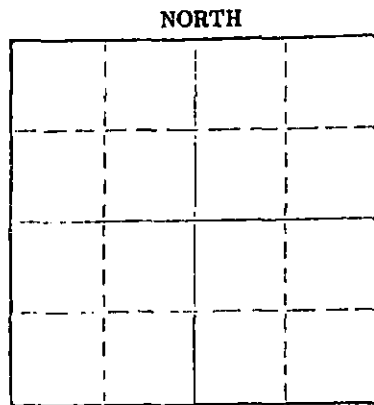

Locate well correctly on above Section Plot

Kingman County, Sec. 34 Twp. 28S Rge. (E) 8 (W)
Location as "NE/CNW&SW&" or footage from lines C SW/4
Lease Owner Keener Oil Company
Lease Name Redetzke Well No. 1
Office Address 406 First National Bank of Tulsa - Tulsa, Oklahoma
Character of Well (completed as Oil, Gas or Dry Hole) Dry Hole
Date well completed March 25, 1977
Application for plugging filed March 25, 1977
Application for plugging approved March 25, 1977
Plugging commenced March 25, 1977
Plugging completed March 25, 1977
Reason for abandonment of well or producing formation Dry Hole

If a producing well is abandoned, date of last production 19
Was permission obtained from the Conservation Division or its agents before plugging was commenced? YES

Name of Conservation Agent who supervised plugging of this well Bud Metz - Stafford, Kansas
Producing formation _____ Depth to top _____ Bottom _____ Total Depth of Well 4138 Feet
Show depth and thickness of all water, oil and gas formations.

OIL, GAS OR WATER RECORDS				CASING RECORD		
FORMATION	CONTENT	FROM	TO	SIZE	PUT IN	PULLED OUT
	Surface					
	Casing	0	213	8 5/8"	213'	none

Describe in detail the manner in which the well was plugged, indicating where the mud fluid was placed and the method or methods used in introducing it into the hole. If cement or other plugs were used, state the character of same and depth placed, from _____ feet to _____ feet for each plug set.

Plug at 240' with 35 sacks cement,
plug at 40' with 1/2 sack hulls and 15 sack cement,
5 sacks in the rat hole. Halliburton Cement Co.,
job completed at 2:00 P.M. - 3-25-77

RECEIVED
CONSERVATION DIVISION

(If additional description is necessary, use BACK of this sheet)
Name of Plugging Contractor Search Drilling Company
Address Wichita, Kansas
MAR 29 1977
3-29-1977

STATE OF Kansas COUNTY OF Sedgwick
R. M. Stagl (employee of owner) or (owner or operator) of the above-described

well, being first duly sworn on oath, says: That I have knowledge of the facts, statements, and matters herein contained and the log of the above-described well as filed and that the same are true and correct. So help me God.

(Signature) R. M. Stagl
Wichita, Kansas (Address)

Subscribed and sworn to before me this 25th day of March, 1977

My commission expires February 22, 1981
Maxine Dressen Notary Public



15095-20557-000

DRILLERS LOG
REDETZKE #1

CASING RECORD:
8 5/8" set at 213'
with 185 sacks cement

OPERATOR: Keener Oil Company

DESCRIPTION:

CONTRACTOR: Search Drilling Company

C SW/4,
Section 34-28S-8W
Kingman County,
Kansas

TOTAL DEPTH:

COMMENCED: March 19, 1977

4138'

COMPLETED: March 25, 1977

<u>FORMATION</u>	<u>FROM</u>	<u>TO</u>	<u>REMARKS</u>
Sand	0	103	
Sand	103	125	
Red Bed	125	226	
Red Bed	226	536	
Red Bed and Shale	536	806	
Anhydrite and Shale	806	1493	
Shale and Lime	1493	1742	
Shale and Lime	1742	2675	
Shale and Lime	2675	3208	
Lime, Shale and Sand	3208	3449	
Lime and Shale	3449	3900	
Lime and Shale	3900	4138	
Rotary Total Depth	4138		

RECEIVED
STATE COMMISSION ON GEOLOGY

D & A

MAR 29 1977

COMMISSIONER OF GEOLOGY
Wichita, Kansas


I certify that this is a true and correct copy of the above log to the best of my knowledge.

SEARCH DRILLING COMPANY


R. M. Stagl

Subscribed and sworn to before me this 25th day of March, 1977

My appointment expires;
February 22, 1981


Maxine Dressen Notary Public

