


15-095-20610-000

STATE OF KANSAS
STATE CORPORATION COMMISSION
CONSERVATION DIVISION
P. O. BOX 17027
WICHITA, KANSAS 67217

FORM CP-4

WELL PLUGGING RECORD

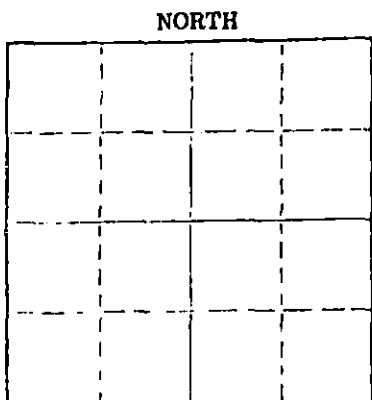

Locate well correctly on above Section Plot

Kingman County, Sec. 34 Twp. 28S Rge. (E) 8 (W)
 Location as "NE/CNWSW" or footage from lines. 100' N of C NE
 Lease Owner Keener Oil Company
 Lease Name Schumacher Well No. 1
 Office Address 406 National Bank of Tulsa - Tulsa, Oklahoma 74103
 Character of Well (completed as Oil, Gas or Dry Hole) dry hole
 Date well completed August 14, 1977
 Application for plugging filed August 14, 1977
 Application for plugging approved August 14, 1977
 Plugging commenced August 14, 1977
 Plugging completed August 14, 1977
 Reason for abandonment of well or producing formation dry hole

If a producing well is abandoned, date of last production 19____
 Was permission obtained from the Conservation Division or its agents before plugging was commenced? yes

Name of Conservation Agent who supervised plugging of this well Bill Owen - Pratt, Kansas
 Producing formation _____ Depth to top _____ Bottom _____ Total Depth of Well 4145 Feet
 Show depth and thickness of all water, oil and gas formations.

OIL, GAS OR WATER RECORDS

CASING RECORD

FORMATION	CONTENT	FROM	TO	SIZE	PUT IN	PULLED OUT
	Surface					
	Casing	0	212	8 5/8"	212'	none

Describe in detail the manner in which the well was plugged, indicating where the mud fluid was placed and the method or methods used in introducing it into the hole. If cement or other plugs were used, state the character of same and depth placed, from _____ feet to _____ feet for each plug set.

210' with 35 sacks cement,
 40' with 12 sacks cement,
 3 sacks in rat hole.
 Job completed at 5:40 P.M.
 August 14, 1977 by Halliburton.

(If additional description is necessary, use BACK of this sheet)

Name of Plugging Contractor Search Drilling Company
 Address Wichita, Kansas

STATE OF Kansas COUNTY OF Sedgwick ss.
 R. M. Stagl (employee of owner) or (owner or operator) of the above-described well, being first duly sworn on oath, says: That I have knowledge of the facts, statements, and matters herein contained and the log of the above-described well as filed and that the same are true and correct. So help me God.

(Signature) R. M. Stagl
 Wichita, Kansas (Address)

Subscribed and sworn to before me this 14th day of August, 1977

My commission expires February 22, 1981
Maxine Dressen
 Maxine Dressen Notary Public.



RECEIVED
 STATE CORPORATION COMMISSION

AUG 16 1977

CONSERVATION DIVISION
 Wichita, Kansas

15-095-20610-000

DRILLERS LOG

C. W. SCHUMACHER #1

CASING RECORD:
8 5/8" set at 212'
with 200 sack cement

OPERATOR: Keener Oil Company

DESCRIPTION:

TOTAL DEPTH:
4145'

CONTRACTOR: Search Drilling Company

100' N of C NE,
Section 34-28S-8W
Kingman County,
Kansas

COMMENCED: August 8, 1977

COMPLETED: August 14, 1977

<u>FORMATION</u>	<u>FROM</u>	<u>TO</u>	<u>REMARKS</u>
Sand	0	110	
Red Bed	110	193	
Shale	193	224	
Red Bed and Shale	224	970	
Shale	970	1336	
Lime and Shale	1336	1435	
Lime and Shale	1435	1840	
Shale and Lime	1840	2179	
Shale and Lime	2179	2499	
Shale and Lime	2499	3375	
Shale and Lime	3375	3891	
Shale and Lime	3891	4139	
Shale and Lime	4139	4145	
Rotary Total Depth	4145		Dry and Abandoned

I certify that this is a true and correct copy of the above log to the best of my knowledge.

SEARCH DRILLING COMPANY

R. M. Stogel

Subscribed and sworn to before me this

day of August, 1977.

My appointment expires:
February 22, 1981

Maxine Dressen
Maxine Dressen Notary Public

