

15-095-21063-0000


STATE OF KANSAS  
STATE CORPORATION COMMISSION

WELL PLUGGING RECORD

Give All Information Completely  
Make Required Affidavit  
File or Deliver Report to  
Conservation Division  
State Corporation Comm.  
245 North Water  
Wichita, KS 67202

Kingman County, Sec. 10 Twp. 29 Rge. 5W  
Location as "NE/CNW $\frac{1}{4}$ SW $\frac{1}{4}$ " or footage from lines  
~~55' E of NE-SE-NE~~ 330' FEL & 895' FSL of NE/4

Lease Owner Rine Exploration  
Lessee Name Shepherd Well No. 1-10  
Office Address Suite 645, 300 West Douglas, Wichita 67202  
Character of Well (Completed as Oil, Gas or Dry Hole)  
Dry Hole

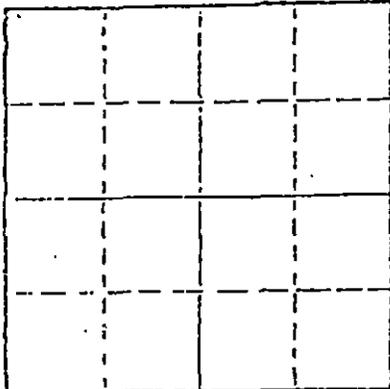

Locate well correctly on above Section Plat

Date Well completed 3/30/81 19  
Application for plugging filed 3/30/81 19  
Application for plugging approved 3/30/81 19  
Plugging commenced 3/30/81 19  
Plugging completed 3/30/81 4 a.m. 19  
Reason for abandonment of well or producing formation

If a producing well is abandoned, date of last production 19

Was permission obtained from the Conservation Division or its agents before plugging was commenced? Yes

Name of Conservation Agent who supervised plugging of this well Maurice V. Leslie  
Producing formation Depth to top Bottom Total Depth of Well  
Now depth and thickness of all water, oil and gas formations. RTD 4465'

OIL, GAS OR WATER RECORDS

CASING RECORD

FORMATION	CONTENT	FROM	TO	SIZE	PUT IN	PULLED OUT
	Surface	0	215'	8-5/8"	yes	no

Describe in detail the manner in which the well was plugged, indicating where the mud fluid was placed and the method or methods used in introducing it into the hold. If cement or other plugs were used, state the character of same and depth placed, from feet to feet for each plug set.

1st plug @ 230' with 40 sacks  
Bridge at 40' with 10 sacks  
10 sacks in rathole  
Job complete @ 4 a.m. 3/30/81

RECEIVED  
STATE CORPORATION COMMISSION  
SEP 24 1982  
CONSERVATION DIVISION  
Wichita, Kansas

(If additional description is necessary, use BACK of this sheet)

Name of Plugging Contractor Slawson Drilling Company, Inc.

STATE OF Kansas COUNTY OF Sedgwick, ss.  
James C. Rensberg, Slawson Drilling Company, Inc. (employee of owner) or (owner or operator) of the above-described well, being first duly sworn on oath, says: That I have knowledge of the facts, statements, and matters herein contained and the log of the above-described well filed and that the same are true and correct. So help me God.

(Signature) James C. Rensberg  
James C. Rensberg  
200 Douglas Building, Wichita 67202  
(Address)

SUBSCRIBED AND SWORN TO before me this 21st day of April 1981

Mary Lou Taylor  
Notary Public.

commission expires January 17, 1985



RECEIVED  
STATE CORPORATION COMMISSION  
SEP 24 1982  
CONSERVATION DIVISION  
Wichita, Kansas

DRILLERS LOG

15-095-21063-0000

OPERATOR: Rine Exploration  
Suite 645, 300 West Douglas  
Wichita, Kansas 67202

WELL NAME: #1-10 Shepherd  
~~55' E of NE SE NE~~ Sec.10-29S-5W 330' FEL & 895' FSL of NE/4  
Kingman County, Kansas

CONTRACTOR: Slawson Drilling Company, Inc.  
200 Douglas Building  
Wichita, Kansas 67202

COMMENCED: 3/20/81

COMPLETED: 3/30/81

RTD: 4465'

SURFACE CASING: 8-5/8" set at 215' with 200 sx cement

0' to 921' Red Bed  
921' to 3950' Lime & Shale  
3950' to 4167' Mississippian  
4167' to 4465' Lime & Shale  
RTD 4465'

STATE OF KANSAS  
COUNTY OF SEDGWICK

I, James C. Remsberg, of the Slawson Drilling Company, Inc.  
hereby state the above is an accurate copy of the Shepherd #1-10 log for  
Rine Exploration.

*James C. Remsberg*  
James C. Remsberg

Subscribed and sworn to me  
this 21st day of April, 1981

*Mary Lou Taylor*  
Mary Lou Taylor, Notary

My commission expires January 17, 1985

