


15-095-20279-000

STATE OF KANSAS  
STATE CORPORATION COMMISSION

Form CP-4

WELL PLUGGING RECORD

Give All Information Completely  
Make Required Affidavit  
Mail or Deliver Report to:  
Conservation Division  
State Corporation Commission  
P. O. Box 17027  
Wichita, Kansas 67217  
NORTH

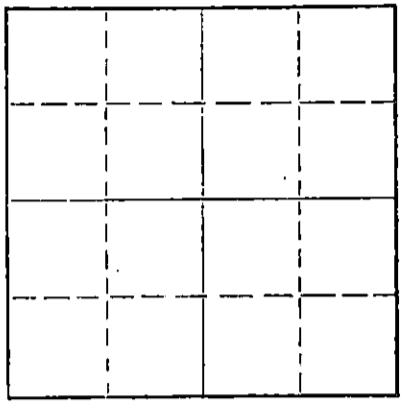

Locate well correctly on above Section Plat

Kingman County, Sec. 14 Twp. 29S Rge. (E) 5W (W)  
Location as "NE/CNW/SE" or footage from lines. NW NW NE  
Lease Owner Clark & Ostertag  
Lease Name Stephens Well No. 1  
Office Address 245 S. Terrace, Wichita, Kansas  
Character of Well (completed as Oil, Gas or Dry Hole) Dry Hole  
Date well completed 6-6 19 72  
Application for plugging filed 6-6 19 72  
Application for plugging approved 6-6 19 72  
Plugging commenced 6-6 19 72  
Plugging completed 6-6 19 72  
Reason for abandonment of well or producing formation No commercial quantities of oil or gas encountered.  
If a producing well is abandoned, date of last production 19  
Was permission obtained from the Conservation Division or its agents before plugging was commenced? Yes

Name of Conservation Agent who supervised plugging of this well Archie Elving  
Producing formation \_\_\_\_\_ Depth to top \_\_\_\_\_ Bottom \_\_\_\_\_ Total Depth of Well 3965 Feet  
Show depth and thickness of all water, oil and gas formations.

OIL, GAS OR WATER RECORDS

CASING RECORD

FORMATION	CONTENT	FROM	TO	SIZE	PUT IN	PULLED OUT
Surface Hole	Water	Surface	209	8-5/8"	203'	None

Describe in detail the manner in which the well was plugged, indicating where the mud fluid was placed and the method or methods used in introducing it into the hole. If cement or other plugs were used, state the character of same and depth placed, from \_\_\_\_\_ feet to \_\_\_\_\_ feet for each plug set.

Fluid to 170', 1/2 sx hulls, plug, 25 sx cement;  
Fluid to 40', 1/2 sx hulls, plug, 10 sx cement;  
Two sacks cement in rat hole.

RECEIVED  
STATE CORPORATION COMMISSION  
JUN 12 1972  
CONSERVATION DIVISION  
Wichita, Kansas

(If additional description is necessary, use BACK of this sheet)

Name of Plugging Contractor D N B DRILLING, INC.  
Address 737 First National Building, Wichita, Kansas 67202

STATE OF Kansas, COUNTY OF \_\_\_\_\_, ss.  
JAMES L. DONELSON (employee of owner) or (owner or operator) of the above-described well, being first duly sworn on oath, says: That I have knowledge of the facts, statements, and matters herein contained and the log of the above-described well as filed and that the same are true and correct. So help me God.

(Signature) James L. Donelson  
737 First Nat'l Bldg., Wichita, Kansas  
(Address)



Subscribed and Sworn to before me this 9th day of June, 1972  
August 25, 1972  
Ella Priess  
Notary Public.

15-095-20279-0000

DRILLERS' LOG

CLARK & OSTERTAG  
No. 1 Stephens  
NW NW NE, Sec. 14-29S-5W  
Kingman County, Kansas

Elev: 1421 R.B.

Commenced: 5-30-72  
Completed: 6-6-72

Surface Casing: 203' of 8-5/8"  
cemented w/157 sx cement, 38 cc.  
5-31-72

<u>FORMATION</u>	<u>DEPTH</u>
Surface Hole	0 - 209
Shale	209 - 877
Lime & Shale	877 - 1127
Shale & Lime	1127 - 2003
Lime & Shale	2003 - 2328
Shale & Lime	2328 - 2592
Lime & Shale	2592 - 2840
Sand & Shale	2840 - 2975
Lime & Shale	2975 - 3391
Lime	3391 - 3590
Lime & Shale	3590 - 3935
Lime	3935 - 3965 T.D.

RECEIVED  
STATE CORPORATION COMMISSION  
JUN 12 1972  
CONSERVATION DIVISION  
Wichita, Kansas

I do hereby certify that the foregoing statements are true and correct to the best of my knowledge and belief.

D N B DRILLING, INC.

*James L. Donelson*  
JAMES L. DONELSON

STATE OF KANSAS: ss:

Subscribed and sworn to before me, the undersigned, a Notary Public in and for said state, this 9th day of June, 1972.

My Commission Expires:  
August 25, 1972

*Ella Priess*

Ella Priess, Notary Public