


STATE OF KANSAS  
STATE CORPORATION COMMISSION  
Give All Information Completely  
Make Required Affidavit  
Mail or Deliver Report to:  
Conservation Division  
State Corporation Commission  
211 No. Broadway  
Wichita, Kansas

WELL PLUGGING RECORD

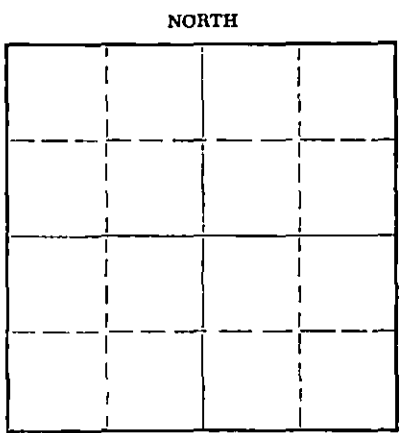

Locate well correctly on above  
Section Plat

Kingman County. Sec. 26 Twp. 28S Rge. 8W (E) (W)  
Location as "NE/CNW&SW" or footage from lines. C NE NE  
Lease Owner Kaiser-Francis, Lario, & Leben  
Lease Name Simons Well No. 1  
Office Address Box 486, Great Bend, Kansas 67530  
Character of Well (completed as Oil, Gas or Dry Hole) Dry Hole  
Date well completed 4-27-67 19  
Application for plugging filed 4-27-67 19  
Application for plugging approved 4-27-67 19  
Plugging commenced 4-27-67 19  
Plugging completed 4-27-67 19  
Reason for abandonment of well or producing formation Dry Hole

If a producing well is abandoned, date of last production 19\_\_\_\_  
Was permission obtained from the Conservation Division or its agents before plugging was commenced? yes

Name of Conservation Agent who supervised plugging of this well Archie Elving  
Producing formation \_\_\_\_\_ Depth to top \_\_\_\_\_ Bottom \_\_\_\_\_ Total Depth of Well 4525 Feet  
Show depth and thickness of all water, oil and gas formations.

OIL, GAS OR WATER RECORDS

CASING RECORD

FORMATION	CONTENT	FROM	TO	SIZE	PUT IN	PULLED OUT
				8 5/8"	218'	none

Describe in detail the manner in which the well was plugged, indicating where the mud fluid was placed and the method or methods used in introducing it into the hole. If cement or other plugs were used, state the character of same and depth placed, from \_\_\_\_\_ feet to \_\_\_\_\_ feet for each plug set.

Filled with mud to 220', set plug, 1/2 sk. hulls & 25 sks. cement  
Filled with mud to 40', set plug, 1/2 sk. hulls & 10 sks. cement  
put 2 sks cem. in rathole

RECEIVED  
STATE CORPORATION COMMISSION  
MAY 2 1967  
CONSERVATION DIVISION  
Wichita, Kansas

(If additional description is necessary, use BACK of this sheet)

Name of Plugging Contractor Leben Drilling, Inc.  
Address Box 486, Great Bend, Kansas 67530

STATE OF KANSAS, COUNTY OF BARTON, ss.  
Leslie Kite (employee of owner) or (owner or operator) of the above-described well, being first duly sworn on oath, says: That I have knowledge of the facts, statements, and matters herein contained and the log of the above-described well as filed and that the same are true and correct. So help me God.

(Signature) Leslie Kite  
Box 486, Great Bend, Kansas 67530  
(Address)

SUBSCRIBED AND SWORN TO before me this 30th day of April, 1967

My commission expires April 1, 1971  
Notary Public.

15-095-20021-0000

DRILLER'S LOG

COMPANY: KAISER-FRANCIS, LARIO & LEBEN  
 CONTRACTOR: LEBEN DRILLING, INC.  
 FARM: SIMONS #1  
 LOCATION: C NE NE SEC. 26-28S-8W  
 KINGMAN COUNTY, KANSAS  
 COMMENCED: 4-16-67  
 COMPLETED: 4-27-67

-----		
0	198	Sand
198	300	Redbed
300	1032	Sand, Shale
1032	1310	Shale, Shells
1310	1529	Shale, Lime
1529	2035	Lime, Shale
2035	2385	Shale, Lime
2385	2925	Lime, Shale
2925	3035	Lime
3035	3385	Lime, Shale
3385	3520	Shale, Lime
3520	4392	Lime
4392	4453	Lime, Shale
4453	4473	Shale, Lime
4473	4479	Lime, Sand
4479	4493	Lime
4493	4507	Sand
4507	4525	Sand
	<u>4525</u>	<u>RTD - D &amp; A</u>

RECEIVED  
 STATE CONSERVATION COMMISSION  
 MAY 2 1967  
 CONSERVATION DIVISION  
 WICHITA, KANSAS

-----

8 5/8" new 20# surface casing set @ 218' cemented with 250 sks. of Common, 2% cc

-----

I, Leslie Kite, do hereby certify that the above and foregoing is a true and correct copy of the log of the Simons #1 Well, located C NE NE of Section 26, Township 28 South, Range 8 West, Kingman County, Kansas, as reflected by the records of Leben Drilling, Inc.

Leslie Kite  
 Leslie Kite

STATE OF KANSAS )  
 ) SS  
 COUNTY OF BARTON )

Subscribed and sworn to and before me, a Notary Public, in and for Barton County, Kansas, this 30th day of April, 1967.

Ulanda Nichols  
 Ulanda Nichols

My Commission Expires:  
 April 1, 1971