


Give All Information Completely
Make Required Affidavit
Mail or Deliver Report to:
Conservation Division
State Corporation Commission
211 No. Broadway
Wichita, Kansas

WELL PLUGGING RECORD

NORTH

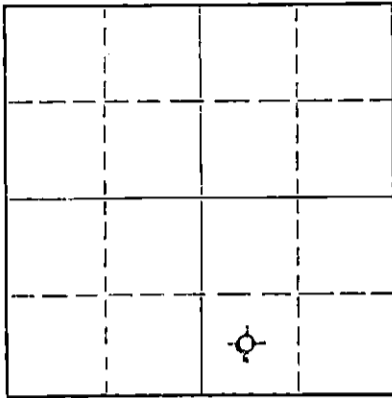

Locate well correctly on above
Section Plat

Kingman County, Sec. 27 Twp. 28S Rge. 8W (X) (W)

Location as "NE/CNW/SW" or footage from lines C SW SE
Lease Owner Reading & Bates Offshore Drilling Co.
Lease Name Covington Well No. 1
Office Address Philtower Building, Tulsa 3, Oklahoma
Character of Well (completed as Oil, Gas or Dry Hole) Dry Hole
Date well completed October 18, 1962 19 62
Application for plugging filed October 22, 1962 19 62
Application for plugging approved October 22, 1962 19 62
Plugging commenced October 18, 1962 19 62
Plugging completed October 18, 1962 19
Reason for abandonment of well or producing formation Dry Hole

If a producing well is abandoned, date of last production _____ 19____
Was permission obtained from the Conservation Division or its agents before plugging was commenced? Yes

Name of Conservation Agent who supervised plugging of this well Herman Justus
Producing formation _____ Depth to top _____ Bottom _____ Total Depth of Well 4540 Feet
Show depth and thickness of all water, oil and gas formations.

OIL, GAS OR WATER RECORDS

CASING RECORD

FORMATION	CONTENT	FROM	TO	SIZE	PUT IN	PULLED OUT
				8-5/8"	221'	

Describe in detail the manner in which the well was plugged, indicating where the mud fluid was placed and the method or methods used in introducing it into the hole. If cement or other plugs were used, state the character of same and depth placed, from _____ feet to _____ feet for each plug set.

Plug @ 150' 1 sk Hulls, 20 sks Cement, Plug @ 35'
sk Hulls, 10 sks cement, 5 sks in Rat Hole.

RECEIVED
STATE CORPORATION COMMISSION
10-23-62
OCT 23 1962
CONSERVATION DIVISION
Wichita, Kansas

Name of Plugging Contractor Jones-Gebert Oil, Inc. (If additional description is necessary, use BACK of this sheet)
Address 1007 Central Building, Wichita, Kansas

STATE OF Kansas, COUNTY OF Sedwick, ss.
George R. Jones ~~(Employee of owner)~~ (owner or operator) of the above-described well, being first duly sworn on oath, says: That I have knowledge of the facts, statements, and matters herein contained and the log of the above-described well as filed and that the same are true and correct. So help me God.

(Signature) George R. Jones
1007 Central Building, Wichita, Kansas
(Address)

SUBSCRIBED AND SWORN TO before me this 22nd day of October, 19 62

My commission expires February 1, 1964
Barbara J. Layton Notary Public.



DRILLERS' LOG

15-095-00453-0000

Company: Reading & Bates
 Contractor: Jones-Gebert Oil, Inc.
 Farm: Covington #1
 Location: C SW SE, Sec. 27-28S-8W
 Kingman County, Kansas
 Commenced: 10-5-62
 Completed: 10-18-62
 Casing: 8-5/8" 221" w/175 sx.

0	-	85	Sand
85	-	128	Clay & Shale
128	-	180	Shale
180	-	221	Red Bed
221	-	240	Shale
240	-	750	Red Bed & Shale
750	-	1210	Shale & Shells
1210	-	1215	Lime
1215	-	1240	Lime
1240	-	1550	Shale & Lime
1550	-	1830	Shale - Lime
1830	-	2005	Lime
2005	-	2235	Lime
2235	-	2500	Shale - Lime
2500	-	2715	Lime & Shale
2715	-	2910	Shale & Lime
2910	-	3080	Lime & Shale
3080	-	3260	Shale & Sand
3260	-	3287	Sand
3287	-	3425	Shale & Lime
3425	-	3525	Lime
3525	-	3585	Lime
3585	-	3670	Lime
3670	-	3734	Lime
3734	-	3805	Lime
3805	-	3865	Lime
3865	-	3885	Lime
3885	-	3950	Lime
3950	-	4017	Lime
4017	-	4075	Lime & Shale
4075	-	4111	Shale - Lime
4111-	-	4131	Miss Chat
4131	-	4219	Chert & Lime
4219	-	4242	Lime
4242	-	4291	Lime
4291	-	4320	Lime & Shale
4320	-	4360	Lime & Shale
4360	-	4420	Shale & Lime
4420	-	4470	Shale & Lime
4470	-	4505	Shale & Lime
4505	-	4515	Lime
4515	-	4540	Sand & Lime
		4540	Rotary Total Depth

RECEIVED
 STATE CORPORATION COMMISSION
 OCT 23 1962
 CONSERVATION DIVISION
 Wichita, Kansas

I, George R. Jones, do hereby certify that the above and foregoing is a true and correct copy of the log of the #1 Covington, C SW SE, Sec. 27-28S-8W, Kingman County, Kansas, as reflected by the files of Jones-Gebert Oil, Inc.

George R. Jones
George R. Jones

State of Kansas)
)
County of Sedgwick)

Subscribed and sworn to before me, a Notary Public, in and for Sedgwick County, Kansas, this 22nd day of October, 1962.

Barbara J. Layton
Barbara J. Layton, Notary Public

My Commission expires:
February 1, 1964

RECEIVED
STATE CORPORATION COMMISSION
OCT 23 1962
CONSERVATION DIVISION
Wichita, Kansas