


WELL PLUGGING RECORD

Give All Information Completely
Make Required Affidavit
Mail or Deliver Report to:
Conservation Division
State Corporation Commission
800 Bitting Building
Wichita, Kansas

NORTH

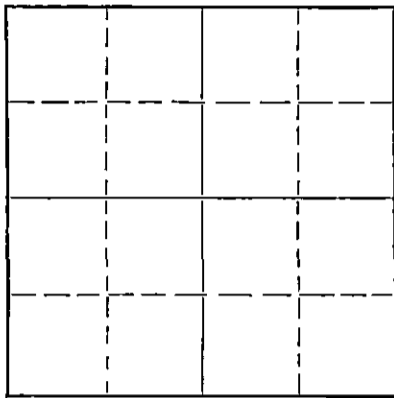

Locate well correctly on above
Section Plat

Location as "NE/CNW $\frac{1}{4}$ SW $\frac{1}{4}$ " or footage from lines NE NE NE
Lease Owner L. C. Smitherman - Oil Producer
Lease Name Seifert Well No. I
Office Address 310 Truman Bldg, El Dorado Kansas
Character of Well (completed as Oil, Gas or Dry Hole) Dry Hole
Date well completed 8-5-50 19
Application for plugging filed 8-5-50 19
Application for plugging approved 8-5-50 19
Plugging commenced 8-5-50 19
Plugging completed 8-5-50 19
Reason for abandonment of well or producing formation

If a producing well is abandoned, date of last production 19
Was permission obtained from the Conservation Division or its agents before plugging was commenced? yes

Name of Conservation Agent who supervised plugging of this well D. C. Stough
Producing formation Depth to top Bottom Total Depth of Well 3832 Feet
Show depth and thickness of all water, oil and gas formations.

OIL, GAS OR WATER RECORDS

CASING RECORD

Formation	Content	From	To	Size	Put In	Pulled Out

Describe in detail the manner in which the well was plugged, indicating where the mud fluid was placed and the method or methods used in introducing it into the hole. If cement or other plugs were used, state the character of same and depth placed, from feet to feet for each plug set.

Pushed bottom plug to 245' and cemented through drill pipe with 15 sz. Pushed top plug to 25' and cemented with 10 sacks.

(If additional description is necessary, use BACK of this sheet)

Correspondence regarding this well should be addressed to L. C. Smitherman - Oil Producer
Address 310 Truman Building
El Dorado Kansas

STATE OF Kansas, COUNTY OF Sedgwick, ss.
D. J. Briggs (employee of owner) or (owner or operator) of the above-described well,

being first duly sworn on oath, says: That I have knowledge of the facts, statements, and matters herein contained and the log of the above-described well as filed and that the same are true and correct. So help me God.

(Signature) D. J. Briggs
D. J. Briggs
818 Central Bldg, Wichita Kansas
(Address)

SUBSCRIBED AND SWORN to before me this 7th day of August 1950

Ruth M. Gushner
Notary Public.

My commission expires March 2, 1953

9-8-50
AUG 6 - 1950

BOOK 20 PAGE 16

CONSERVATION
DIVISION
KANSAS

D R I L L E R S L O G

COMPANY: L. C. Smitherman
 CONTRACTOR: Pabco Drilling, Inc.

LOCATION: NE NE NE
 17 ~~21-28S-5W~~
 Kingman Co
 Kansas

FARM NAME: No. 1 Seifert

COMMENCED: 7-24-50
 COMPLETED: 8-6-50

PRODUCTION: D & A

CASING USED:
 250' 8 5/8" cem w 135 sx

Shale & Shells	250	
Sand Shale & Shells	675	
Shale & Salt	825	SLM at 800' OK
Lime	885	
Shale & Shells	925	
Shale & Lime	1080	SHT at 1000' OK
Lime	1295	
Shale & Lime	1375	
Shale & Lime	1550	SHT OK
Shale & Lime	2140	SLM OK SHT OK
Shale & Lime	2615	SLM & SHT OK at 2500'
Lime	2745	
Lime & Shale	2890	SLM at 2784' OK
Lime	3005	
Lime & Shale	3134	
Lime	3190	
Shale & Lime	3382	
Lime	3762	SLM OK at 3592'
Lime	3832	
Total Depth	3832	

STATE OF KANSAS)
 COUNTY OF SEDGWICK) SS:

I, D. J. Briggs, do hereby certify that the above is a true and correct copy of the log on the above captioned well, as shown on the daily drilling reports.

PABCO DRILLING, INC.

D. J. Briggs
 D. J. Briggs

Subscribed and sworn before me this 7th day of August, 1950.

Ruth M. Gardner
 Notary Public

My commission expires March 2, 1953.

