


15-095-20500000

STATE OF KANSAS
STATE CORPORATION COMMISSION

Form CP-4

Give All Information Completely
Make Required Affidavit
Mail or Deliver Report to:
Conservation Division
State Corporation Commission
P. O. Box 17027
Wichita, Kansas 67217
NORTH

WELL PLUGGING RECORD

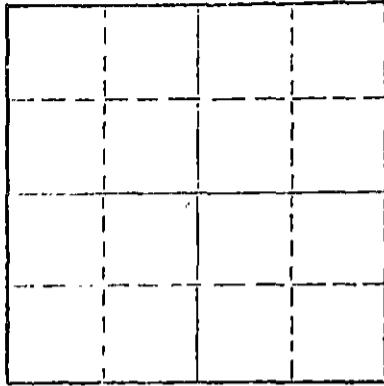

Locate well correctly on above
Section Plot

Kingman County, Sec. 12 Twp. 28 Rge. 5W (E) (W)
SE-NE-NW
Location as "NE/CNWxSWx" or footage from lines
Lease Owner Graves Drilling Co.
Lease Name Jones Well No. 1
Office Address 910 Union Center, Wichita, Kansas 67202
Character of Well (completed as Oil, Gas or Dry Hole) oil
Date well completed 19
Application for plugging filed 2-21- 19 77
Application for plugging approved 2-22- 19 77
Plugging commenced 2-25- 19 77
Plugging completed 3-2- (2:00) 19 77
Reason for abandonment of well or producing formation not productive

If a producing well is abandoned, date of last production 19
Was permission obtained from the Conservation Division or its agents before plugging was commenced? yes

Name of Conservation Agent who supervised plugging of this well Bud Metz
Producing formation Depth to top Bottom Total Depth of Well 3839 Feet
Show depth and thickness of all water, oil and gas formations.

OIL, GAS OR WATER RECORDS

CASING RECORD

FORMATION	CONTENT	FROM	TO	SIZE	PUT IN	PULLED OUT
				8 5/8	206	None
				4 1/2	3838	3528

Describe in detail the manner in which the well was plugged, indicating where the mud fluid was placed and the method or methods used in introducing it into the hole. If cement or other plugs were used, state the character of same and depth placed, from feet to feet for each plug set.

Sand from 3830' to 3790'
4 sacks cement from 3790' to 3750'

Ripped pipe at 3528'

Wooden bridge at 200'
Rock from 200' to 190'

4 yards ready mix to surface

RECEIVED
STATE CORPORATION COMMISSION
MAR 08 1977
3-8-77
CONSERVATION DIVISION
Wichita, Kansas

Name of Plugging Contractor Clarke Corporation
Address Box 187, Medicine Lodge, Kansas 67104
(If additional description is necessary, use BACK of this sheet)

STATE OF Kansas, COUNTY OF Barber, ss.
Elmo R. Marguier (employee of owner) or (owner or operator) of the above-described well, being first duly sworn on oath, says: That I have knowledge of the facts, statements, and matters herein contained and the log of the above-described well as filed and that the same are true and correct. So help me God.

(Signature) Elmo R. Marguier
Medicine Lodge, Kansas
(Address)

Subscribed and sworn to before me this 3rd day of March, 1977

My commission expires April 4, 1978

Jessie Hamilton
Notary Public.

ROTARY DRILLERS LOG 15-095-20500000

OPERATOR: John C. Graves, et al
910 Union Center
Wichita, Kansas 67202

DRILLING COMMENCED: July 28, 1976

CONTRACTOR: Graves Drilling Co., Inc.
910 Union Center
Wichita, Kansas 67202

DRILLING COMPLETED: August 5, 1976

CASING RECORD: 5 Jts. 202' used 8 5/8"
cemented with 175 sacks

117 Jts. 3840' new 4 1/2"
cemented with 75 sacks

LOCATION: Jones No. 1
SE NE NW
Section 12-28S-5W
Kingman County, Kansas

0 - 202	Red Bed
202 - 469	Shale and Red Bed
469 - 1016	Shale and Sand
1016 - 1305	Shale
1305 - 1590	Shale and Shells
1590 - 1714	Shale
1714 - 2050	Shale and Shells
2050 - 2940	Shale
2940 - 3235	Shale and Lime
3235 - 3665	Lime and Shale
3665 - 3789	Lime
3789 - 3819	Lime and Shale
3819 - 3843	Lime and Chert
3843	Rotary Total Depth

I hereby certify the foregoing statements to be true and correct to the best of my knowledge.

GRAVES DRILLING CO., INC.

By Betty Brault
Secretary-Treasurer

STATE OF KANSAS)
) ss
SEDGWICK COUNTY)

Subscribed and sworn to before me, a Notary Public, this 26th day of August, 1976.

Ruth N. Benjamin
Ruth N. Benjamin Notary Public

My commission expires: June 17, 1977