


STATE OF KANSAS  
STATE CORPORATION COMMISSION

Form CP-4

Give All Information Completely  
Make Required Affidavit  
Mail or Deliver Report to:  
Conservation Division  
State Corporation Commission  
211 No. Broadway  
Wichita, Kansas

WELL PLUGGING RECORD

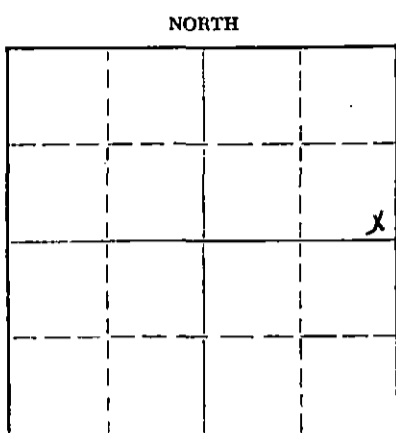

Locate well correctly on above  
Section Plat

Kingman County, Sec. 1 Twp. 29 Rge. 6 (E) (W)  
Location as "NE/CNWxSWx" or footage from lines SE SE NE  
Lease Owner Stelbar Oil Corporation, Inc.  
Lease Name Kostner "A" Well No. 1  
Office Address 310 Petroleum Bldg., Wichita, Kansas  
Character of Well (completed as Oil, Gas or Dry Hole) oil well  
Date well completed 6-15-60 19  
Application for plugging filed 4-7-65 19  
Application for plugging approved 19  
Plugging commenced 4-12-65 19  
Plugging completed 4-13-65 19  
Reason for abandonment of well or producing formation depleted

If a producing well is abandoned, date of last production 19  
Was permission obtained from the Conservation Division or its agents before plugging was commenced? yes

Name of Conservation Agent who supervised plugging of this well Archie Elving  
Producing formation \_\_\_\_\_ Depth to top \_\_\_\_\_ Bottom \_\_\_\_\_ Total Depth of Well 3999 Feet  
Show depth and thickness of all water, oil and gas formations.

OIL, GAS OR WATER RECORDS

CASING RECORD

FORMATION	CONTENT	FROM	TO	SIZE	PUT IN	PULLED OUT
				8 5/8	261	none
				5 1/2	3998	3346.53

Describe in detail the manner in which the well was plugged, indicating where the mud fluid was placed and the method or methods used in introducing it into the hole. If cement or other plugs were used, state the character of same and depth placed, from \_\_\_\_\_ feet to \_\_\_\_\_ feet for each plug set.

Well had been perforated with top of perforation at 3910'.  
Fill hole with sand from 3999' to 3900' and dump 5 sacks of cement.  
Mud hole to 260'. Set 10' rock bridge at 260' and dump 25 sacks  
of cement. Mud hole to 40'. Set 10' rock bridge at 40' and dump  
10 sacks of cement.

RECEIVED  
STATE CORPORATION COMMISSION

APR 22 1965  
4-22-65

CONSERVATION DIVISION  
Wichita, Kansas

(If additional description is necessary, use BACK of this sheet)

Name of Plugging Contractor Flint Engineering & Construction Company  
Address Box 950, El Dorado, Kansas

STATE OF KANSAS, COUNTY OF BUTLER, ss.  
\_\_\_\_\_, (employee of owner) or (owner or operator) of the above-described well, being first duly sworn on oath, says: That I have knowledge of the facts, statements, and matters herein contained and the log of the above-described well as filed and that the same are true and correct. So help me God.

(Signature) Jama Bawdle  
El Dorado, Kansas  
(Address)

SUBSCRIBED AND SWORN TO before me this 20th day of April, 1965

My commission expires 9-27-67


Ronald R. Hansen  
Notary Public.

15-095-00929-0000  
Murdach

399

# WELL RECORD

WELL NO 1

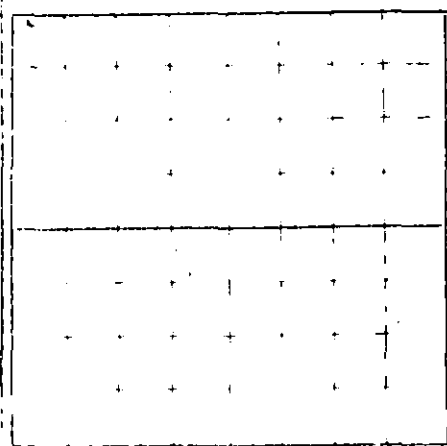

**Kostner "A"** LEASE

COMPANY **Stelbar** ACRES \_\_\_\_\_

RECORD COMPILED **6-21** 19**60** By **lh**

SEC **I** TWP **29** RGE **6W** COUNTY **Kingman** STATE **Kansas**

SURVEY \_\_\_\_\_ BLOCK \_\_\_\_\_ SECTION \_\_\_\_\_

LOCATION **SE SE NE**

STAKED BY \_\_\_\_\_ DATE \_\_\_\_\_ 19 \_\_\_\_\_ ELEVATION **1405 Gr**  
**1407 Dr**

RIG COMMENCED **5-30** 19**60** COMPLETED **6-15-** 19**60** CONTR **Stelbar**

TOOLS	STARTED	COMPLETED	FROM	TO	CONTRACTOR
REBAR	5-30-60	6-15-60	0	3999	Stelbar


COMPLETION METHOD **put on pump**

GAS WELL SHUT IN PRESSURE \_\_\_\_\_ VOLUME \_\_\_\_\_ M CU FT

## casing AND TUBING RECORD

IN. DIA.	DEPTH	CASING TYPE	WT.	PS.	PI. GRADE	CASING POINT.	PULLED	LEFT IN	CEMENT		REMARKS
									SACKS	ESTIMATED TOP	
12-1/4"	8-5/8"	new				261'		261'	200	FT	
	5-1/2"	new				3998'			100		

### (2) ACIDIZING RECORD

### (3) PRODUCING METHODS

DATE	WELL FLOWING NATURAL FROM	19	TO	19
	PRODUCED BY GAS LIFT		IN TUBING FROM	19 TO 19
	OTHER LIFTS			
	PUT ON JACK/BEAM/UNIT			

### (4) SAND RECORD

	NAME	Samples	Log <sup>m</sup>	Date	CONTENT	COLOR, HARD OR SOFT
	Heebner	2805				
	Toronto	2873				
	Douglas	2923				
	Brown Lime	3046	3045	-1635		
	Lansing	3137	3131	-1721		
	Kansas City	3304	3303	-1893		
	Base Kansas City	3555	3548	-2138		
	Marmaton	3595	3592	-2182		
	Cherokee	3774	3771	-2361		
	Mississippi	3894	3891	-2481		

*l. o. Wildcat*

(INUED)

