


STATE OF KANSAS
STATE CORPORATION COMMISSION

Give All Information Completely
Make Required Affidavit
Mail or Deliver Report to:
Conservation Division
State Corporation Commission
211 No. Broadway
Wichita, Kansas

WELL PLUGGING RECORD

NORTH

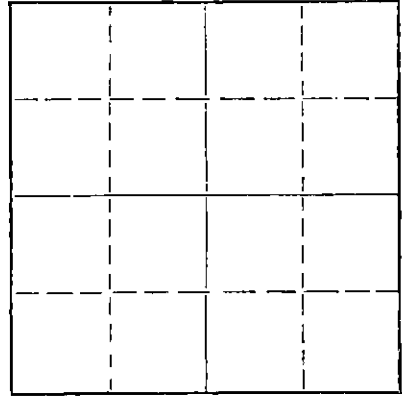

Locate well correctly on above
Section Plat

Kingman County, Sec. 1 Twp. 29 Rge. (E) 6 (W)
Location as "NE/CNWxSWx" or footage from lines NW SE NE
Lease Owner Stelbar Oil Corporation, Inc.
Lease Name Kostner A Well No. 2
Office Address 310 Petroleum Bldg., Wichita 2, Kansas
Character of Well (completed as Oil, Gas or Dry Hole) dry hole
Date well completed January 25, 1962
Application for plugging filed January 25, 1962
Application for plugging approved January 25, 1962
Plugging commenced January 25, 1962
Plugging completed January 25, 1962
Reason for abandonment of well or producing formation dry hole

If a producing well is abandoned, date of last production _____ 19____
Was permission obtained from the Conservation Division or its agents before plugging was commenced? yes

Name of Conservation Agent who supervised plugging of this well Eugene Graham
Producing formation _____ Depth to top _____ Bottom _____ Total Depth of Well 4310 Feet
Show depth and thickness of all water, oil and gas formations.

OIL, GAS OR WATER RECORDS

CASING RECORD

FORMATION	CONTENT	FROM	TO	SIZE	PUT IN	PULLED OUT
				8-5/8"	270'	

Describe in detail the manner in which the well was plugged, indicating where the mud fluid was placed and the method or methods used in introducing it into the hole. If cement or other plugs were used, state the character of same and depth placed, from _____ feet to _____ feet for each plug set.

Filled with mud to 240', set plug and dumped 20 sacks cement; mud to 40', set plug and dumped 10 sacks cement, 2 sacks in rat hole.

RECEIVED
STATE CORPORATION COMMISSION

FEB 1 1962 2-1-1962

CONSERVATION DIVISION
WICHITA, KANSAS

(If additional description is necessary, use BACK of this sheet)

Name of Plugging Contractor Stelbar Oil Corporation, Inc.
Address 310 Petroleum Bldg., Wichita, Kansas

STATE OF Kansas, COUNTY OF Sedgwick, ss.
Bertrand M. Lester, Jr. (employee of owner) or (XXXXXXXXXXXX) of the above-described well, being first duly sworn on oath, says: That I have knowledge of the facts, statements, and matters herein contained and the log of the above-described well as filed and that the same are true and correct. So help me God.

(Signature) Bertrand M. Lester Jr.
310 Petroleum Bldg., Wichita 2, Kansas
(Address)

SUBSCRIBED AND SWORN TO before me this 31 day of January, 19 62

Leona Hargrove
Leona Hargrove Notary Public.

My commission expires January 18, 1964



LOG

Farm: Kostner A
 Well No: 2
 NW SE NE 1-29-6W
 Kingman County, Kansas

Drilling Commenced: 1-11-62
 Drilling Completed: 1-25-62
 Owner: Stelbar Oil Corporation, Inc.
 Operator: Stelbar Oil Corporation, Inc.

Elevation: 1408 DF

1405 GR

8-5/8" 270' cemented with 470 sacks

0	55	Sand and Clay
55	65	Gravel
65	270	Broken Lime
270	996	Shale and Shells
996	1150	Shale and Lime
1150	1360	Shale and Shells
1360	1634	Shale and Lime
1634	1893	Lime and Shells
1893	2753	Lime and Shale
2753	2895	Lime
2895	3241	Lime and Shale
3241	3344	Lime
3344	3440	Lime and Shale
3440	3554	Lime
3554	3557	Shale and Lime
3557	3674	Lime
3674	3896	Shale and Lime
3896	3908	Mississippi Lime
3908	4281	Lime
4281	4300	Viola
4300	4305	Simpson Sand
4305	4310	Sand

RECEIVED
 STATE CORPORATION COMMISSION

FEB 1 1962

CONSERVATION DIVISION
 Wichita, Kansas

Mud to 240', set plug and dumped 20 sacks cement; mud to 40', set plug and dumped 10 sacks cement, 2 sacks in rat hole.