

This form shall be filed in duplicate with the Kansas Corporation Commission, 200 Colorado Derby Building, Wichita, Kansas 67202, within ten days after the completion of the well, regardless of how the well was completed.

Attach separate letter of request if the information is to be held confidential. If confidential, only file one copy. Information on side one will be of public record and side two will then be held confidential.

Circle one: Oil, Gas, Dry, SWD, OWWO, Injection. Type and complete ALL sections. Applications must be filed for dual completion, commingling, SWD and injection, T.A.

Attach wireline logs (i.e. electrical log, sonic log, gamma ray neutron log, etc.). KCC # (316) 263-3238. (Rules 82-2-105 & 82-2-125)

OPERATOR Oxford Exploration Company

API NO. 15-095-21,253

ADDRESS 1550 Denver Club Building
Denver, CO 80202

COUNTY Kingman

FIELD West Pat Creek

**CONTACT PERSON David E. Park, Jr.

PROD. FORMATION Indian Creek

PHONE (303) 572-3821

LEASE Adelhardt (formerly Conrad)

PURCHASER unknown*

WELL NO. 31-8

ADDRESS

WELL LOCATION C E/2 NE

DRILLING Murfin Drilling Company

1320 Ft. from North Line and

CONTRACTOR

660 Ft. from East Line of

ADDRESS 617 Union Center

the NE/4 SEC. 31 TWP. 28s RGE. 9w


Wichita, KS 67202

WELL PLAT

PLUGGING

CONTRACTOR

ADDRESS

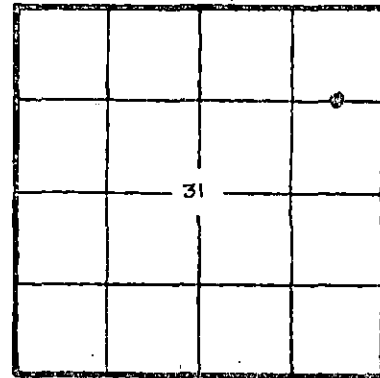

KCC
KGS
(Office Use)

TOTAL DEPTH 2530' PBD

SPUD DATE 7-23-82 DATE COMPLETED 8-5-82

ELEV: GR 1711 DF KB 1716

DRILLED WITH (CABLE) (ROTARY) (XXX) TOOLS

Amount of surface pipe set and cemented 262' DV Tool Used?

AFFIDAVIT

STATE OF Colorado, COUNTY OF Denver SS, I,

David E. Park, Jr. OF LAWFUL AGE, BEING FIRST DULY SWORN UPON HIS OATH,

DEPOSES THAT HE IS President (FOR)(OF) Oxford Exploration Company

OPERATOR OF THE Adelhardt (formerly Conard) LEASE, AND IS DULY AUTHORIZED TO MAKE

THIS AFFIDAVIT FOR AND ON BEHALF OF SAID OPERATOR, THAT WELL NO. 31-8 ON

SAID LEASE HAS BEEN COMPLETED AS OF THE DAY OF 1982, AND THAT

ALL INFORMATION ENTERED HEREIN WITH RESPECT TO SAID WELL IS TRUE AND CORRECT.

FURTHER AFFIANT SAITH
Conservation Division
Wichita, Kansas

(s) David E. Park, Jr.
David E. Park, Jr. President

SUBSCRIBED AND SWORN BEFORE ME THIS 9th DAY OF August, 1982

B.B. Taylor
NOTARY PUBLIC (B.B. Taylor)

MY COMMISSION EXPIRES: January 29, 1986

**The person who can be reached by phone regarding any questions concerning this information. Within 45 days of completion, a witnessed initial test by the Commission is required if the well produces more than 25 BOPD or is located in a Basic Order Pool.

* Operator will send information when known.

WELL LOG

Show all important zones of permeability and contents thereof; cored intervals, and all drill-stem tests, including depth interval tested, cushion used, time tool open, flowing and shut-in pressures, and recoveries.

SHOW GEOLOGICAL MARKERS, LOGS RUN, OR OTHER DESCRIPTIVE INFORMATION.

FORMATION DESCRIPTION, CONTENTS, ETC.	TOP	BOTTOM	NAME	DEPTH
DST #1 2407' - 2428' 15-30-45-90 Recovered 150' GCM, no water. IHP 1253, FHP 1219, IFP 567, FFP 545, ISIP 905, FSIP 900.			Indian Cave	2422'

RELEASED
SEP 01 1983
FROM CONFIDENTIAL

Report of all strings set — surface, intermediate, production, etc. **CASING RECORD** (New) or (Used)

Purpose of string	Size hole drilled	Size casing set (in O.D.)	Weight lbs/ft.	Setting depth	Type cement	Socks	Type and percent additives
Surface Casing	12 1/4	8 5/8	24	262'	common	225	3% CC
Production		4 1/2		2530'	common, 50-50 pozmix	25 75	2% gel, 18% salt, 3/4% CFR2

LINER RECORD

PERFORATION RECORD

Top, ft.	Bottom, ft.	Socks cement	Shots per ft.	Size & type	Depth interval
			9	jet gun	2423' - 2427'

TUBING RECORD

Size	Setting depth	Packer set at
2 3/8"	2452'	none

ACID, FRACTURE, SHOT, CEMENT SQUEEZE RECORD

Amount and kind of material used	Depth interval treated

Date of first production	Producing method (flowing, pumping, gas lift, etc.)	Gravity
awaiting pipeline hook-up*		

RATE OF PRODUCTION PER 24 HOURS	Oil	Gas	Water	Gas-oil ratio
	bbfs.	850 MCF	%	bbfs. CFPB

Disposition of gas (vented, used on lease or sold)	Perforations

Operator will send information when available.