

STATE OF KANSAS  
STATE CORPORATION COMMISSION

WELL PLUGGING RECORD

OR  
FORMATION PLUGGING RECORD


Strike out upper line  
when reporting plug-  
ging off formations.

Give All Information Completely  
Make Required Affidavit  
Mail or Deliver Report to:  
Conservation Division  
State Corporation Commission  
800 Bittling Building  
Wichita, Kansas

RENO County. Sec. 34 Twp. 23S. Rge. 4W (SE) W 1/2 (NW) SE 1/4

Location as "NE 1/4 NW 1/4 SW 1/4" or footage from lines.....  
Lease Owner..... OLSON DRILLING COMPANY  
Lease Name..... E. J. England Well No. 3  
Office Address..... Petroleum Bldg., Tulsa, Okla.  
Character of Well (completed as Oil, Gas or Dry Hole) Oil  
Date well completed..... unknown 19.....  
Application for plugging filed..... September 19 46  
Application for plugging approved..... October 19 46  
Plugging commenced..... December 19 46  
Plugging completed..... December 19 46  
Reason for abandonment of well or producing formation..... dry

NORTH

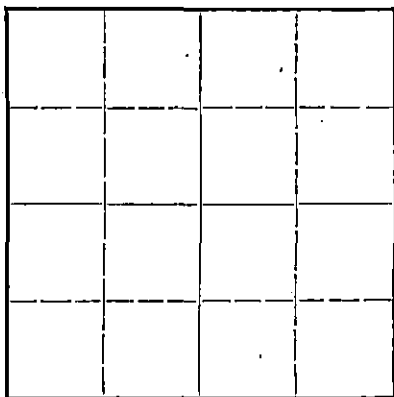

Locate well correctly on above  
Section Flat

If a producing well is abandoned, date of last production..... unknown 19.....  
Was permission obtained from the Conservation Division or its agents before plugging was com-  
menced?.....

Name of Conservation Agent who supervised plugging of this well..... Mr. Paul Durkee  
Producing formation..... Depth to top..... Bottom..... Total Depth of Well..... 3334' Feet

Show depth and thickness of all water, oil and gas formations.

OIL, GAS OR WATER RECORDS

CASING RECORD

Formation	Content	From	To	Size	Put In	Pulled Out
				16"	263'	none
				13"	505'	none
				7"	2990'	2700'

Describe in detail the manner in which the well was plugged, indicating where the mud fluid was placed and the method or methods used in introducing it into the hold. If cement or other plugs were used, state the character of same and depth placed, from..... feet to..... feet for each plug set.

Dumped 6 sacks of cement at 3334'. Shot pipe off at 2700'.  
Pulled pipe, mudded hole and put <sup>cement</sup> bridge at 325'. Forty sacks of cement  
at 325'. Mudded surface pipe and put 10 sacks of cement in top of surface pipe.

FILE 34 23 410  
500 70 38

(If additional description is necessary, use BACK of this sheet)

Correspondence regarding this well should be addressed to..... Herman Kaiser Pipe & Supply Company  
Address..... 819-20 Palace Bldg., Tulsa, Okla.

STATE OF Oklahoma, COUNTY OF Tulsa, ss. Berthold Neuwald (employee of owner) or (owner or operator) of the above-described well, being first duly sworn on oath, says: That I have knowledge of the facts, statements, and matters herein contained and the log of the above-described well as filed and that the same are true and correct. So help me God.

(Signature) Berthold Neuwald

819-20 Palace Bldg., Tulsa, Okla. (Address) 1-21-47

SUBSCRIBED AND SWORN to before me this 20th day of January, 1947.

My Commission Expires Nov. 3, 1950

My commission expires.....

Alfred Pittman  
Notary Public.

15-155-62683-6006

DLDG.  
OLSON OIL COMPANY  
E. J. ENGLAND #4  
SW SW SE 34 23S 4W  
RENO COUNTY, KANSAS.

COMMENCED 3-12-35  
COMPLETED 4-13-35  
ELEVATION 1473'

CASING RECORD

15 1/2" 55# 350'  
7" 22# 3593'  
7" Cem. W/ 500 Sac. Cem.

0  
96--Sand  
250--Shale  
335-- " & lime sh.  
530-- "  
549--Sand  
700--Shale & lime sh.  
730-- " "  
810-- " "  
934-- " " "  
945--Red rock  
990--Shale & lime sh.  
1010--Lime  
52--Shale  
1150-- " "  
1225-- " " "  
1600-- "  
1841-- " " "  
2109-- "  
2221-- " "  
91--Broken lime  
2431--Shale & lime  
2562--Broken lime  
2629--Shale & lime  
77--Lime  
2730--Shale & lime  
87--Lime  
2812--Broken lime  
25--Lime  
51--Broken lime  
2918--Lime  
26-- " ,Oolitic  
43--Lime  
74--Broken lime  
3007--Lime  
60--Shale & lime sh.  
71-- " "  
3109-- " " "  
30-- " "  
3250--Var. shale  
3365--Chat  
3499--Lime  
3595--Shale  
3601--Lime, R.u.s.t.  
3604--Lime  
T.D.

Plugged back to 3516'  
shot Chat @ 3325 1/2 65 w/  
80 shots.  
Filled up 300' oil in  
4 hours.

FILE  
BOOK 34 23-40  
70-38

