

15-155-02682-0000

STATE OF KANSAS
STATE CORPORATION COMMISSION

WELL PLUGGING RECORD

Give All Information Completely
Make Oath and Affidavit
Date of Report to:
Conservation Division
State Corporation Commission
800 Building Building
Wichita, Kansas


OR

FORMATION PLUGGING RECORD

Strike out upper line
when reporting plug-
ging of formations.

Reno County Sec. 34 Twp. 23S Rge. 4E 4 (W)

Location as "NE 1/4 NW 1/4 SW 1/4" or footage from lines SE NW SE
Lease Owner Olson Drilling Co.
Lease Name E.J. England Well No. 3
Office Address Tulsa, Okla.
Character of Well (completed as Oil, Gas or Dry Hole) Oil
Date well completed 4-7 19 35
Application for plugging filed 10 - 15 19 45
Application for plugging approved 10 - 16 19 45
Plugging commenced 12 - 12 19 45
Plugging completed 12 - 27 19 45
Reason for abandonment of well or producing formation Dry

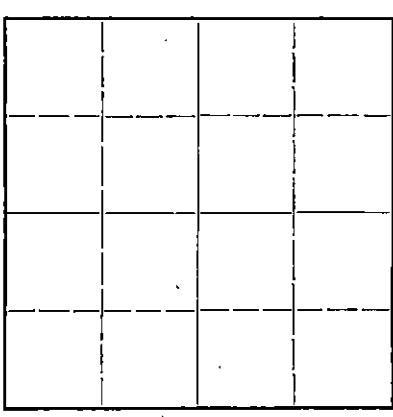

Locate well correctly on above
Section Plat

If a producing well is abandoned, date of last production February 19 45
Was permission obtained from the Conservation Division or its agents before plugging was com-
menced? Yes

Name of Conservation Agent who supervised plugging of this well Ruel Durkee
Producing formation Hunton Depth to top 3502 Bottom 3604 Total Depth of Well 3604 Feet
Show depth and thickness of all water, oil and gas formations.

OIL, GAS OR WATER RECORDS

CASING RECORD

Formation	Content	From	To	Size	Put In	Pulled Out
Hunton Lime	Oil	3502	3604	15 1/2"	249'	None
				7"	3593	1814' 6"

Describe in detail the manner in which the well was plugged, indicating where the mud fluid was placed and the method or methods used in introducing it into the hole. If cement or other plugs were used, state the character of same and depth placed, from feet to feet for each plug set.

Filled hole with crushed rock from 3604 to 3593, put in 6 sacks of cement, filled hole with mud to 250', filled hole with rock from 250' to 245', ran 30 sacks of cement from 245' to 220', filled with mud from 220' to 20', from 20' to cellar cap with 10 sacks of cement.

Well log sent in with plugging application

PLUGGING
FILE NO. 34 23 46
BOOK PAGE 29 LINE 5



(If additional description is necessary, use BACK of this sheet)

Correspondence regarding this well should be addressed to J.L. McMannis % Olson Drilling Co.
Address Burrton, Kansas

STATE OF Kansas, COUNTY OF Harvey, ss.

J.L. McMannis (employee of owner) or (owner or operator) of the above-described well, being first duly sworn on oath, says: That I have knowledge of the facts, statements, and matters herein contained and the log of the above-described well as filed and that the same are true and correct. So help me God.

(Signature) J.L. McMannis

(Address)

SUBSCRIBED AND SWORN TO before me this 4th day of January, 19 46

My commission expires 7-22-48

A.L. Heidebrecht
Notary Public.

15-155-02682-0000

Dldg.
OLSON OIL COMPANY
E. J. ENGLAND #3
SE NW SE 34 23S. 4W
RENO COUNTY, KANSAS.

COMMENCED 3-5-35
COMPLETED 4-7-35
ELEVATION 1471'

CASING RECORD

0
25--Sand
170-- " & clay
250--Lime & shale
493--Shale & lime sh.
635-- " " "
930-- " " "
945--red rock
1027--Lime
1104--Broken lime
46--Shale & lime sh.
53--Lime
64--Shale & lime sh.
1270-- " "
83-- "
1332-- " " "
1499--Sandy shale
60--Shale & lime sh.
93--Broken lime
1654--Shale & Lime sh.
84--Lime
1840--Shale & lime sh.
1900--Lime
18--Broken lime
2027--Lime
52--Broken lime
2100--Lime
36--Shale
48-- " & lime
89--Lime
2258--Broken lime
2328--Lime
50--Broken lime
2445--Lime
89--Broken lime
2512--Lime
26--Broken lime
2630--Lime
50--Broken lime
60--Lime
67--Broken lime
88--Lime
2792--Broken lime
2907--Lime & shale
13--Lime, Oolitic
22-- "
56--Broken lime
62--Lime
3028-- " & shale
94-- "
3146--Broken lime
53--Shale

3176--Shale & lime
89--Broken lime
99--Lime
3217--Shale
32-- " & lime sh.
55-- "
3460--Chat
3502--Lime
93--Shale. R.u.s.t.
94--Lime & sand
3604--Lime shale
T.D.

15 1/2" 70# 249'
7" 22# 3593'

FILE 34 28-40
BOOK 39 PAGE 5

STARTED
OCT 1935