


WELL PLUGGING RECORD

Give All Information Completely  
Make Required Affidavit  
Mail or Deliver Report to:  
Conservation Division  
State Corporation Commission  
211 No. Broadway  
Wichita, Kansas

Reno County, Sec. 34 Twp. 23 Rge. 4 (NE) X (W)  
Location as "NE/CNW/SE/SW" or footage from lines SW NW NW  
Lease Owner WOCO, INC.  
Lease Name Eash-Miller Well No. 2  
Office Address 2225 E. 21st Street, Suite 205, Wichita, Kansas 67214  
Character of Well (completed as Oil, Gas or Dry Hole) Oil  
Date well completed December 20, 1967  
Application for plugging filed \_\_\_\_\_ 19\_\_\_\_  
Application for plugging approved \_\_\_\_\_ 19\_\_\_\_  
Plugging commenced September 14, 1976  
Plugging completed September 15, 1976  
Reason for abandonment of well or producing formation \_\_\_\_\_  
Hole in casing - casing parted  
If a producing well is abandoned, date of last production \_\_\_\_\_ 1973  
Was permission obtained from the Conservation Division or its agents before plugging was commenced? Yes

NORTH

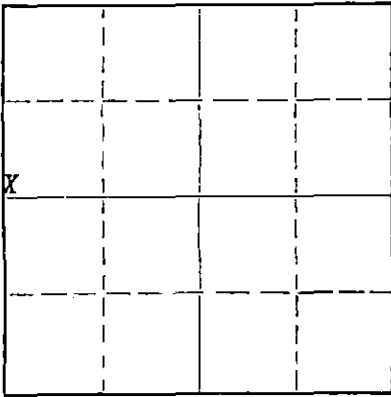

Locate well correctly on above Section Plat

Name of Conservation Agent who supervised plugging of this well Gilbert J. Tomon  
Producing formation Mississippi Depth to top 3,309 Bottom 3,344 Total Depth of Well 3,344 Feet  
Show depth and thickness of all water, oil and gas formations.

OIL, GAS OR WATER RECORDS

CASING RECORD

FORMATION	CONTENT	FROM	TO	SIZE	PUT IN	PULLED OUT
				10 3/4"	250'	None
				8 5/8"	545"	None
				5 1/2"	3,342'	405'

Describe in detail the manner in which the well was plugged, indicating where the mud fluid was placed and the method or methods used in introducing it into the hole. If cement or other plugs were used, state the character of same and depth placed, from \_\_\_\_\_ feet to \_\_\_\_\_ feet for each plug set.

9-14-76 ( 30 sks. gel w/10 sks. Hulls pumped through tubing at 450'  
( 35 sks. cement pumped through tubing at 450'  
( 50 sks. cement pumped through tubing at 450'  
(100 sks. cement pumped through tubing at 450' - Top at 436'  
  
9-15-76 ( 28 sks. gel w/15 sacks cement pumped through tubing at 310' - no fill up  
( 8 yds. ready-mix dumped into 8 5/8" casing - Filled to base of collar  
( 50 sks. cement pumped into 13 3/8" and annulus filled  
  
Totals: 58 sks. gel  
25 sks. hulls  
235 sks. cement  
8 yds ready-mix

9-20-76

(If additional description is necessary, use BACK of this sheet)

Name of Plugging Contractor \_\_\_\_\_  
Address \_\_\_\_\_

STATE OF Kansas COUNTY OF Sedgwick, ss.  
H. L. Wofford (employee of owner) or (owner or operator) of the above-described well, being first duly sworn on oath, says: That I have knowledge of the facts, statements, and matters herein contained and the log of the above-described well as filed and that the same are true and correct. So help me God.

(Signature) H. L. Wofford  
2225 E. 21st Street - Suite 205  
(Address)

SUBSCRIBED AND SWORN TO before me this 17th day of September, 1976

My commission expires \_\_\_\_\_

**JOHNNIE MAE ROSS**  
NOTARY PUBLIC  
Sedgwick County, Kansas  
My Appt. Exp. 11-21-79

Notary Public.