


WELL PLUGGING RECORD

15-155-02690-000

Give All Information Completely
Make Required Affidavit
Mail or Deliver Report to:
Conservation Division
State Corporation Commission
800 Bitting Building
Wichita, Kansas

Reno County, Sec. 34 Twp. 23 Rge. 4 (W)

Location as "NE/CNW $\frac{1}{4}$ SW $\frac{1}{4}$ " or footage from lines SE NE SE
Lease Owner Sohio Petroleum Company
Lease Name McElwain Well No. 7
Office Address Russell, Kansas
Character of Well (completed as Oil, Gas or Dry Hole) Oil
Date well completed August 19 36
Application for plugging filed 8-7 19 50
Application for plugging approved 8-9 19 50
Plugging commenced 8-24 19 50
Plugging completed 9-4 19 50
Reason for abandonment of well or producing formation Uneconomical
If a producing well is abandoned, date of last production 8-17 19 50
Was permission obtained from the Conservation Division or its agents before plugging was commenced? Yes

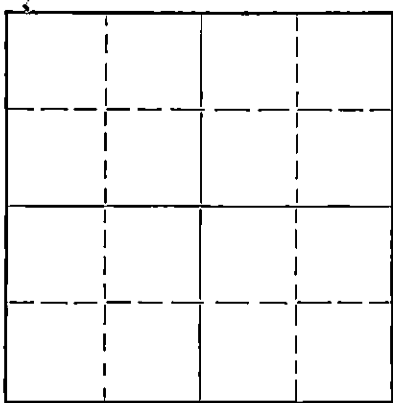

Locate well correctly on above Section Plat

Name of Conservation Agent who supervised plugging of this well Rueb Durkee
Producing formation Mississippi Chat Depth to top Bottom Total Depth of Well 3360 Feet
Show depth and thickness of all water, oil and gas formations.

OIL, GAS OR WATER RECORDS

CASING RECORD

Formation	Content	From	To	Size	Put In	Pulled Out
Mississippi Chat		3317	3360	5 1/2"	3317'	3271'
Shale		3252	3317	7"	3252'	2860'

Describe in detail the manner in which the well was plugged, indicating where the mud fluid was placed and the method or methods used in introducing it into the hole. If cement or other plugs were used, state the character of same and depth placed, from feet to feet for each plug set.

3360' to 3252' Heavy Mud
3252' to 3230' Plug & crushed rock & 8 sacks cement
3230' to 250' Heavy Mud
250' to 240' Plug & 25 sacks cement
240' to 15' Heavy Mud
15' to Bottom cellar - 10 sacks cement

9-14-50

SEE 14 1950

(If additional description is necessary, use BACK of this sheet)

Correspondence regarding this well should be addressed to Sohio Petroleum Company
Address Box 671
Russell, Kansas


STATE OF KANSAS COUNTY OF RUSSELL
J. H. Bond (employee of owner) or (owner or operator) of the above-described well,
being first duly sworn on oath, says: That I have knowledge of the facts, statements, and matters herein contained and the log of the above-described well as filed and that the same are true and correct. So help me God.

(Signature) J. H. Bond
Box 671, Russell, Kansas
(Address)

SUBSCRIBED AND SWORN to before me this 12 day of September 19 50

My Commission Expires July 2, 1953

Russell Miller
Notary Public.

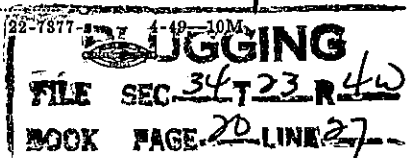

My commission expires

LOG

Sohio Petroleum Company

McElwain No. 7

15-155-02690-0000

Top	Bottom	Formation and Remarks
100	153	Sand & Shale
153	183	Clay & Shale
183	454	Shale, Shells
454	491	Shale & Lime
491	494	Lime
494	827	Shale, Lime
827	961	Broken Lime
961	1048	Lime, Shale
1048	1141	Shale & Lime
1141	1296	Shale
1296	1472	Shale, Shells
1472	1601	Shale
1601	1735	Shale
1735	1836	Shale, Shells
1836	1913	Shale
1913	2003	Shale, Lime
2003	2063	Broken Lime
2063	2185	Lime, Shale
2185	2238	Broken Lime
2238	2304	Lime
2304	2401	Shale
2401	2492	Shale & Sand
2492	2542	Broken Lime & Shale
2542	2594	Broken Lime
2594	2635	Lime
2635	2957	Lime
2957	2994	Shale & Lime
2994	3045	Lime, Shale
3045	3080	Sticky Shale
3080	3252	Shale
3252	3317	Chat
3317	3360	Oil bearing chat

Casing Record

15 1/8"	153'
12 1/8"	494'
6 5/8"	3252'
5 3-16"	3317'

with Robinson
Bottom hole
canvas packer

First Oil 3330 to 3341
Second oil 3350 to 3360

1/2 M. gas with oil

RECEIVED
Conservation Div.

SEP 6 X 1950 AUG 9 - 1950

STATE OF KANSAS
COMMISSION ON
KANSAS

PLUGGING
FILE SEC 34 T 23 R 46
BOOK PAGE 20 LINE 27