

15-083-21098-0000


STATE OF KANSAS  
STATE CORPORATION COMMISSION

WELL PLUGGING RECORD

Give All Information Completely  
Make Required Affidavit  
Mail or Deliver Report to  
Conservation Division  
State Corporation Comm.  
245 North Water  
Wichita, KS 67202

Hodgeman County. Sec. 27 Twp. 24S Rge. 21 NE/W  
Location as "NE/CNW 1/4 SW 1/4" or footage from lines  
SW SW

Lease Owner Credo Petroleum Corporation  
Lease Name Benish Well No. #1  
Office Address 1905 Sherman St. - Suite 700, Denver, CO 80203  
Character of Well (Completed as Oil, Gas or Dry Hole)  
Dry Hole

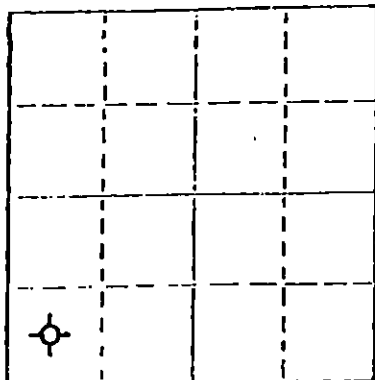

Date Well completed 1-10-84 19  
Application for plugging filed 1-10-84 19  
Application for plugging approved 1-10-84 19  
Plugging commenced 1-10-84 19  
Plugging completed 1-10-84 19  
Reason for abandonment of well or producing formation  
Commercial quantities of oil not found  
If a producing well is abandoned, date of last production 19.

Was permission obtained from the Conservation Division or its agents before plugging was commenced? Yes

Name of Conservation Agent who supervised plugging of this well  
Producing formation Depth to top Bottom Total Depth of Well 4755'  
Show depth and thickness of all water, oil and gas formations.

OIL, GAS OR WATER RECORDS

CASING RECORD

FORMATION	CONTENT	FROM	TO	SIZE	PUT IN	PULLED OUT
				8 5/8"	445'	None

Describe in detail the manner in which the well was plugged, indicating where the mud fluid was placed and the method or methods used in introducing it into the hold. If cement or other plugs were used, state the character of same and depth placed, from feet to feet for each plug set.

Plug @ 1400' w/50 sx.  
Plug @ 500' w/50 sx.  
Plug @ 40' w/10 sx.  
Rat Hole 15 sx.

(If additional description is necessary, use BACK of this sheet)

Name of Plugging Contractor Buffalo Drilling Co., Inc.


STATE OF Kansas COUNTY OF Sedgwick, ss.  
Jerald W. Rains, President of Buffalo Drilling Co., Inc. (employee of owner) or (owner or operator) of the above-described well, being first duly sworn on oath, says: That I have knowledge of the facts, statements, and matters herein contained and the log of the above-described well as filed and that the same are true and correct. So help me, God.

(Signature) Jerald W. Rains  
435 Page Court, 220 W. Douglas, Wichita, KS 67202  
(Address)

SUBSCRIBED AND SWORN TO before me this 23 day of January, 1984

Juanita M. Green  
Juanita M. Green Notary Public.

My commission expires 10-4-87

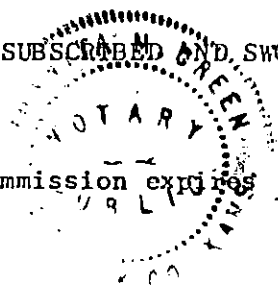

RECEIVED  
STATE CORPORATION COMMISSION

FEB 06 1984

CONSERVATION DIVISION  
Wichita, Kansas