

STATE OF KANSAS  
STATE CORPORATION COMMISSION

WELL PLUGGING RECORD

Give all information completely  
Make Required Affidavit  
Mail or Deliver Report to:  
Conservation Division  
State Corporation Commission  
800 Bittling Building  
Wichita, Kansas


OR

Strike out upper line  
when reporting plugging  
of formations.

~~FORMATION PLUGGING RECORD~~

W/2 SW/4 Reno County. Sec. 3 Twp. 24S Rge. (E) 4 (W)  
Location as "NE 1/4 NW 1/4 SW 1/4" or footage from lines 660' fm Nth 560' fm West line.

Lease Owner Sinclair Oil & Gas Co  
Lease Name Mary Collins Well No. 3  
Office Address Box 521, Tulsa, Okla.  
Character of Well (completed as Oil, Gas or Dry Hole) oil  
Date well completed May 1 ~~1938~~ 19 38  
Application for plugging filed June 28 19 49  
Application for plugging approved July 5 19 49  
Plugging commenced June 25 19 49  
Plugging completed July 2 19 49  
Reason for abandonment of well or producing formation Production depleted

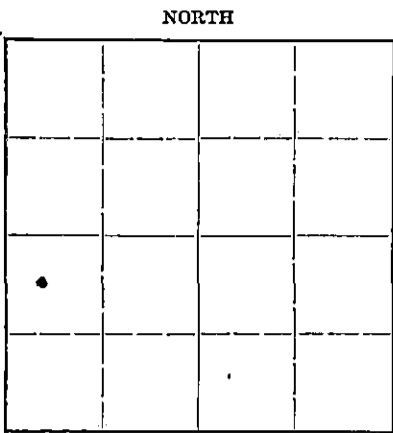

Locate well correctly on above  
Section Plat

If a producing well is abandoned, date of last production June 19 49  
Was permission obtained from the Conservation Division or its agents before plugging was commenced? yes

Name of Conservation Agent who supervised plugging of this well Ruel Durkee  
Producing formation Chat Depth to top 3265 Bottom 3360 Total Depth of Well 3368 feet  
Show depth and thickness of all water, oil and gas formations.

OIL, GAS OR WATER RECORDS

CASING RECORD

Formation	Content	From	To	Size	Put In	Pulled Out
Chat	dry	3265	3360	16"	360'	0
				8-5/8"	3275'	2498'

Describe in detail the manner in which the well was plugged, indicating where the mud fluid was placed and the method or methods used in introducing it into the hold. If cement or other plugs were used, state the character of same and depth placed, from \_\_\_\_\_ feet to \_\_\_\_\_ feet for each plug set.

- 3368-3275 crushed rock
- 3275-3235 cement 8 sx
- 3235- 360 mud
- 360-350 rock
- 350- 320 cement 30 sx
- 320- 15 mud
- 15- 0 cement 10 sx

7-13-49

RECEIVED  
JUL 13 1949  
STATE CORPORATION COMMISSION  
KANSAS

(If additional description is necessary, use BACK of this sheet)

Correspondence regarding this well should be addressed to Mr. E.H. Gibbons  
Address Box 551 Chase, Kans

STATE OF Kansas, COUNTY OF Rice, SS.  
I, E.H. Gibbons (employee of owner) or ~~owner~~ of the above-described well,  
being first duly sworn on oath, says: That I have knowledge of the facts, statements, and matters herein contained and the log of the above-described well as filed and that the same are true and correct. So help me God.

(Signature) E.H. Gibbons  
Box 551 Chase, Kans  
(Address)

SUBSCRIBED AND SWORN to before me this 12th day of July, 1949  
D. Lloyd J. Gaster  
Notary Public.

My commission expires Jan 15, 1950  
PLUGGING  
SEC. 3 Twp. 24 R. 4w  
PAGE 104 LINE 4

WELL LOG  
Sinclair Oil & Gas Company

Mary Collins # 3  
W/2 SW/4, 3-24S-4W, Reno Co., Kas  
660' fm Nth, 560' fm West lines

Drilling Begun Apr 6, 1938  
Drilling completed May 1, 1938

361' of 15 1/2" 385sx cmt.  
3377' of 8-5/8" 200 sx cmt.

Drillers Log

Sand & Shale	181'
Shale	426
Shale & Shells	650
Lime & Shale	700
Lime	868
Shale & Lime	1097
Broken Lime	1405
Shale & Shells	1542
Shale & Lime	2038
Shale-Shells-Lime	2229
Broken lime	2520
Shale-sticky	2606
Lime-hard	2667
Lime	2815
Lime-KC	2871
Lime	2960
Shale	3021
Shale & Lime	3100
Lime	3175
Broken Lime	3268
Chat	3368 TD

Handwritten notes and stamps at the bottom left of the page, including a date stamp "Jul - 5 1949".

