


WELL PLUGGING RECORD

STATE OF KANSAS STATE CORPORATION COMMISSION

Give All Information Completely Make Required Affidavit Mail or Deliver Report to: Conservation Division State Corporation Commission 800 Bittling Building Wichita, Kansas

OR FORMATION PLUGGING RECORD Strike out upper line when reporting plugging off formations.

NORTH

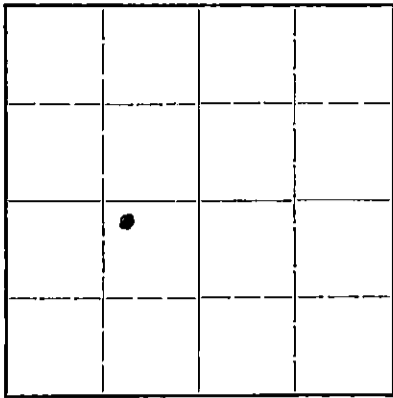

Locate well correctly on above Section Plat

Reno County Sec. 3 Twp. 24 Rge. (E) 4 (W) Location as "NE 1/4 NW 1/4 SW 1/4" or footage from lines E/2 SW/4 330' fm Nth & West line Lease Owner Sinclair Prairie Oil Co Lease Name Guy T. Matlack Well No. 1 Office Address Box 521, Tulsa, Okla. Character of Well (completed as Oil, Gas or Dry Hole) Oil Well Date well completed Dec. 5 19.35 Application for plugging filed Sept. 13 19.47 Application for plugging approved Sept. 17 19.47 Plugging commenced Sept. 13 19.47 Plugging completed Sept. 19 19.47 Reason for abandonment of well or producing formation Production depleted If a producing well is abandoned, date of last production August 19.47 Was permission obtained from the Conservation Division or its agents before plugging was commenced? Yes

Name of Conservation Agent who supervised plugging of this well Ruel Durkee Producing formation Chat Depth to top 3261 Bottom Total Depth of Well 3379 Feet Show depth and thickness of all water, oil and gas formations.

OIL, GAS OR WATER RECORDS

CASING RECORD

Table with 7 columns: Formation, Content, From, To, Size, Put In, Pulled Out. Row 1: Chat, dry, 3261, 3379, 1 1/2, 246, 0. Row 2: Chat, dry, 3261, 3379, 8-5/8, 3585, 2490.

Describe in detail the manner in which the well was plugged, indicating where the mud fluid was placed and the method or methods used in introducing it into the hole. If cement or other plugs were used, state the character of same and depth placed, from feet to feet for each plug set.

3370- 350! Mud
350- 315! Cement 35 sx
315- 20! Mud
20- cellar base Cement 21 sx



(If additional description is necessary, use BACK of this sheet)

Correspondence regarding this well should be addressed to E.H. Gibbons Address Box 774 Great Bend, Kas.

STATE OF Kansas, COUNTY OF Barton, ss. I, E.H. Gibbons (employee of owner) or (owner or operator) of the above-described well, being first duly sworn on oath, says: That I have knowledge of the facts, statements, and matters herein contained and the log of the above-described well as filed and that the same are true and correct. So help me God.

(Signature) [Signature]

Box 774 Great Bend, Kans (Address)

SUBSCRIBED AND SWORN to before me this 13 day of October, 1947

My commission expires 9/22/54

[Signature] Notary Public.

PLUGGING FILE SEC-3 T.24 R.40 BOX PAGE 133 LINE 42

15-155-02894-0000

Well Log  
Sinclair Prairie Oil Co

G.T. Matlack # 1  
E/2 SW/4,3-24S-4W  
Reno Co., Kas  
Elev. 1470

Brilling Begun 10-5-1935  
Drilling Comp. 12-5-1935  
15 1/2" csg set at 246' w/ 246 sx  
8-5/8 " " 3585' w/350 sx

Sand & Gravel	200
Shale & Shells	1000
Lime	1030
Shale & Shells	1720
Shale & Lime	1797
Shale & Shells	1993
Shale & Lime	2233
Shale & Shells	2440
Lime-K.C.	2935
Shale & Shells	2955
Lime & Shale	3035
Lime	3131
Shale & Lime	3161
Lime	3194
Shale	3261
Chat Lime	3465
Lime	3520
Shale	3593
Lime-Hunton	3601 TD

In 1942 plugged back to TD 3379' in Chat

**PLUGGING**  
 FILE SEC 3 24 R 4W  
 BOOK PAGE 133 LINE 42

STATE COMMISSION  
 COMMISSIONER  
 SEP 17 1947