


15095-21392-0000

WELL PLUGGING RECORD

Give All Information Completely
 Make Required Affidavit

COUNTY Pratt SEC. 8 TWP. 28S RGE. 9W E/W
 Location as in quarters or footage from lines:
C/NW

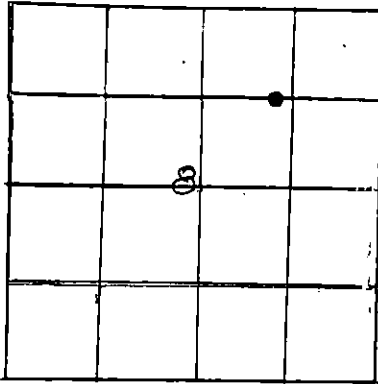

Locate Well
 correctly on above
 Section Pratt.

Lease Owner Kimbark Oil & Gas Co.
 Lease Name Kjellin Well No. 1-8
 Office Address 1580 Lincoln, Suite 700, Denver, Colo 80203
 Character of Well (Completed as Oil, Gas or Dry Hole): Dry Hole
 Date Well Completed 11/16/83
 Application for plugging filed 11/16/83
 Plugging commenced 11/16/83
 Plugging completed 11/16/83
 Reason for abandonment of well or producing formation Dry hole

Was permission obtained from the Conservation Division or it's
 Agent's before plugging was commenced? Yes

Name of Conservation Agent who supervised plugging of this well Don Thompson
 Producing formation _____ Depth to top _____ bottom T.D. 2550'
 Show depth and thickness of all water, oil and gas formations.

OIL, GAS OR WATER RECORDS

Casing Record

Formation	Content	From	To	Size	Put in	Pulled Out
				8 5/8"	348'	None

Describe in detail the manner in which the well was plugged, indicating where the mud
 fluid was placed and the method or methods used in introducing it into the hold. If cement
 or other plugs were used, state the character of same and depth placed, from _____ feet
 to _____ feet for each plug set.

Plugged w/ 70 sks @ 570'
 25 sks @ 60'
 10 sks Rathole
 10 sks in Mousehole
 Cement: 60-40 Poz, 2% Gel, 3% CC

RECEIVED
 STATE CORPORATION COMMISSION
 LLC 7 1983
 CONSERVATION DIVISION
 Wichita, Kansas

(If additional description is necessary, use BACK of this sheet)

Name of Plugging Contractor Sun Cementing

STATE OF Kansas COUNTY OF Sedgwick, ss.
Cheryl Benoit (employee of owner) or (owner or operator) of the
 above-described well, being first duly sworn on oath, says: That I have knowledge of the
 facts, statements, and matters herein contained and the log of the above-described well as
 filed and that the same are true and correct. So help me God.

(Signature) Cheryl Benoit
 401 E. Douglas, Suite 402, Wichita, Ks 67202
 (Address)

SUBSCRIBED AND SWORN TO before me this 23rd day of November, 19 83

Marca J Dearth
 Notary Public.

My Commission expires: 4/27/85

