

15-095-20832-0000


STATE OF KANSAS
STATE CORPORATION COMMISSION

WELL PLUGGING RECORD

Give All Information Completely
Make Required Affidavit
Mail or Deliver Report to
Conservation Division
State Corporation Comm.
245 North Water
Wichita, KS 67202

Kingman County, Sec. 9 Twp. 28S Rge. 9W ~~xxx~~
Location as "NE/CNW $\frac{1}{4}$ SW $\frac{1}{4}$ " or footage from lines

SE SE SE
Lease Owner John J. Darrah, Jr. & Topper Resources
Lease Name Wilson Well No. 1
Office Address 1010 Century Plaza, Wichita, Ks. 67202
Character of Well (Completed as Oil, Gas or Dry Hole)

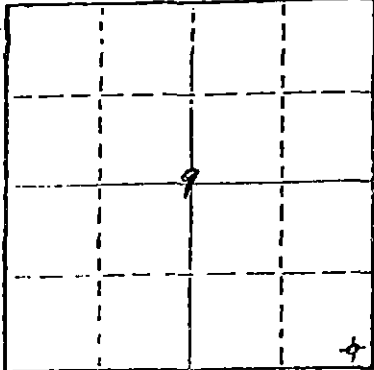

Locate well correctly on above
Section Plat

Dry Hole
Date Well completed April 24, 1979
Application for plugging filed April 24, 1979
Application for plugging approved April 24, 1979
Plugging commenced April 25, 1979
Plugging completed April 25, 1979
Reason for abandonment of well or producing formation

Dry Hole
If a producing well is abandoned, date of last production 19

Was permission obtained from the Conservation Division or
its agents before plugging was commenced? Yes

Name of Conservation Agent who supervised plugging of this well Wm. T. Owen
Producing formation Depth to top Bottom Total Depth of Well 4456'
Show depth and thickness of all water, oil and gas formations.

OIL, GAS OR WATER RECORDS

CASING RECORD

FORMATION	CONTENT	FROM	TO	SIZE	PUT IN	PULLED OUT
		0'	334'	8-5/8"	327.53'	None

Describe in detail the manner in which the well was plugged, indicating where the mud fluid
was placed and the method or methods used in introducing it into the hold. If cement or other
plugs were used, state the character of same and depth placed, from feet to
feet for each plug set.

Plugged with 40 sacks cement and plug at 300',
12 sacks cement and plug at 40', and 3 sacks
cement in rat hole.


(If additional description is necessary, use BACK of this sheet)

Name of Plugging Contractor Allied Cementing Co.

STATE OF KANSAS COUNTY OF SEDGWICK, ss.
John D. Knightley Agent (employee of owner) or (owner or operator)
of the above-described well, being first duly sworn on oath, says: That I have knowledge of
the facts, statements, and matters herein contained and the log of the above-described well
as filed and that the same are true and correct. So help me God.

(Signature) *[Signature]*
221 S. Broadway, Wichita, Kansas
(Address)

SUBSCRIBED AND SWORN TO before me this 11th day of May, 1979

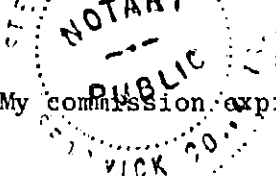

My commission expires March 12, 1983

RECEIVED
STATE CORPORATION COMMISSION
[Signature]
Notary Public.

MAY 14 1979

CONSERVATION DIVISION
Wichita, Kansas

15-095-20832-0000

John J. Darrah, Jr.
& Topper Resources -
1010 Century Plaza Bldg.
Wichita, Kansas 67202

Wilson #1
SE SE SE Sec. 9-28S-9W
Kingman County, Kansas

Contractor: D. R. Lauck Oil Company, Inc.
221 S. Broadway, Suite 400
Wichita, Kansas 67202

Commenced: April 16, 1979
Completed: April 25, 1979

Drillers Log

Sand	100
Red Bed	600
Shale	1530
Shale & Shells	2585
Shale & Lime	3065
Lime & Shale	3815
Lime	4181
Lime & Shale	4279
Lime	4456 RTD

RECEIVED
STATE CORPORATION COMMISSION

MAY 14 1979

CONSERVATION DIVISION
Wichita, Kansas