


STATE OF KANSAS
STATE CORPORATION COMMISSION

Give All Information Completely
Make Required Affidavit
Mail or Deliver Report to:
Conservation Division
State Corporation Commission
211 No. Broadway
Wichita, Kansas

WELL PLUGGING RECORD

15-095 00105 0000

NORTH

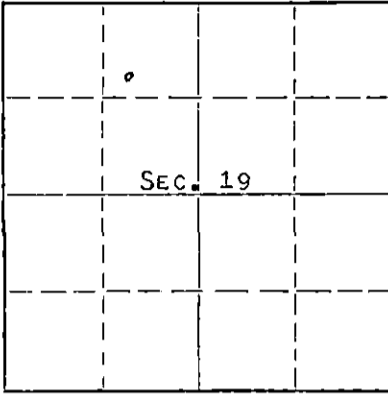

Locate well correctly on above Section Plat

KINGMAN County. Sec. 19 Twp. 28S Rge. 9W (X) (W)
Location as "NE/CNW%SW%" or footage from lines APPROX. SW NE NW
Lease Owner PETROLEUM, INC.
Lease Name LINDT Well No. 1
Office Address ROUTE 2, GREAT BEND, KANSAS
Character of Well (completed as Oil, Gas or Dry Hole) DRY HOLE
Date well completed JANUARY 13, 19 62
Application for plugging filed JANUARY 13, 19 62
Application for plugging approved JANUARY 13, 19 62
Plugging commenced JANUARY 13, 19 62
Plugging completed JANUARY 13, 19 62
Reason for abandonment of well or producing formation NO PRODUCIBLE ZONES

If a producing well is abandoned, date of last production NONE 19
Was permission obtained from the Conservation Division or its agents before plugging was commenced? YES

Name of Conservation Agent who supervised plugging of this well FRED HAMPEL, PRETTY PRAIRIE, KANSAS
Producing formation --- Depth to top --- Bottom --- Total Depth of Well 4500 Feet
Show depth and thickness of all water, oil and gas formations.

OIL, GAS OR WATER RECORDS

CASING RECORD

FORMATION	CONTENT	FROM	TO	SIZE	PUT IN	PULLED OUT
				8-5/8"	292	NONE

Describe in detail the manner in which the well was plugged, indicating where the mud fluid was placed and the method or methods used in introducing it into the hole. If cement or other plugs were used, state the character of same and depth placed, from feet to feet for each plug set.

MUDDERED UP WITH HEAVY MUD TO 270' FOLLOWED BY WOODEN PLUG AND 1/4 SACK HULLS. PLACED 20 SACKS CEMENT THROUGH DRILL PIPE ONTO HULLS. MUDDERED UP WITH HEAVY MUD TO 35' FOLLOWED BY WOODEN PLUG, 1/4 SACK HULLS AND 10 SACKS CEMENT TO BASE OF WELL CELLAR. 2 SACKS CEMENT IN RAT HOLE.

RECEIVED
STATE CORPORATION COMMISSION

FEB 1 1962 02-12-62

CONSERVATION DIVISION
Wichita, Kansas

(If additional description is necessary, use BACK of this sheet)

Name of Plugging Contractor GARVEY DRILLING COMPANY
Address ROUTE 2, GREAT BEND, KANSAS

STATE OF KANSAS, COUNTY OF BARTON, ss.
DON SEARLE (employee of owner) or (XXXXXXXXXXXX) of the above-described well, being first duly sworn on oath, says: That I have knowledge of the facts, statements, and matters herein contained and the log of the above-described well as filed and that the same are true and correct. So help me God. DIST. PROD. SUPT.
(Signature) Don Searle
ROUTE 2, GREAT BEND, KANSAS
(Address)

SUBSCRIBED AND SWORN TO before me this 9TH day of FEBRUARY, 19 62

My commission expires APRIL 14, 1963

Arthur J. Miles

Notary Public.



WELL LOG

15-095-00105-0000

COMPANY PETROLEUM, INCORPORATED

SEC. 19 T. 28S R. 9W

FARM LINDT NO. 1


LOC. Approx. SW, NE, NW

TOTAL DEPTH 4500'

COUNTY KINGMAN CO., KANSAS

COMM. December 29, 1961 COMP. January 13, 1962

CONTRACTOR GARVEY DRILLING COMPANY

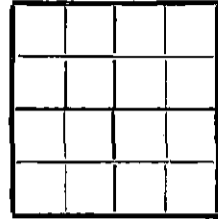

CASING 8-5/8" @ 292' w/200 sax.

ELEVATION 1682' DF

PRODUCTION D & A

FIGURES INDICATE BOTTOM OF FORMATIONS

95	Shale & sand
230	Red rock
292	Red bed
1195	Shale & shells
1207	Anhydrite
1600	Shale & lime
2000	Lime & shale
2130	Shale w/lime streaks
2265	Lime & shale
2690	Shale & lime
2787	Broken lime
3105	Lime & shale
3230	Lime
3320	Lime & shale
3402	Lime
3493	Lime & shale
3945	Lime
4000	Lime & shale
4100	Lime
4150	Mississippi chat
4166	Lime
4220	Shale
4270	Shale & lime
4375	Shale
4390	Shale & lime
4410	Lime
4475	Lime & shale
4500	Sand & shale
4500	T. D.

RECEIVED
STATE CORPORATION COMMISSION
FEB. 16 1962
CONSERVATION DIVISION
Wichita, Kan.

State of KANSAS }
County of BARTON } ss

I, WERNE A. MORRIS of GARVEY DRILLING COMPANY

upon oath state the above and foregoing is a true and correct copy of the log of the #1 LINDT well.

Werne A. Morris

Subscribed and sworn to before me this 7th day of February 1962

My Commission Expires: April 14, 1963

Arthur J. Mile
NOTARY PUBLIC