

15-095-01531-0000

# WELL PLUGGING RECORD

STATE OF KANSAS  
STATE CORPORATION COMMISSION

Give All Information Completely  
Make Required Affidavits  
Mail or Deliver Report to:  
Conservation Division  
State Corporation Commission  
800 Biting Building  
Wichita, Kansas


OR

## FORMATION PLUGGING RECORD

Strike out upper line  
when reporting plug-  
ging off formations.

Kingman County, Sec. 19 Twp. 28S Rge. (E) 9 (W) 9  
 Location as "NE $\frac{1}{4}$ NW $\frac{1}{4}$ SW $\frac{1}{4}$ " or footage from lines Center of E/2 of SE $\frac{1}{4}$  of SE $\frac{1}{4}$   
 Lease Owner The Globe Oil & Refining Co.  
 Lease Name Allen Well No. 1  
 Office Address 301 South Market, Wichita, Kansas  
 Character of Well (completed as Oil, Gas or Dry Hole) Dry Hole  
 Date well completed October 12, 1947  
 Application for plugging filed October 12, 1947  
 Application for plugging approved October 12, 1947  
 Plugging commenced October 12, 1947  
 Plugging completed October 12, 1947  
 Reason for abandonment of well or producing formation Dry Hole

NORTH

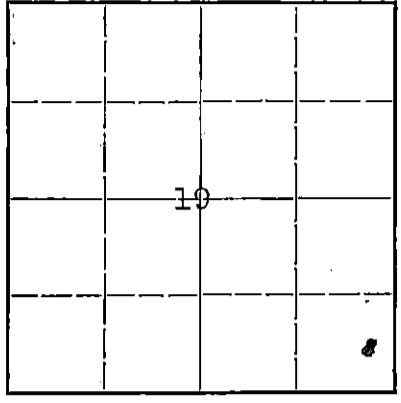

Locate well correctly on above Section Plat

If a producing well is abandoned, date of last production 19  
 Was permission obtained from the Conservation Division or its agents before plugging was commenced? Yes

Name of Conservation Agent who supervised plugging of this well  
 Producing formation Depth to top Bottom Total Depth of Well 4410 Feet  
 Show depth and thickness of all water, oil and gas formations.


### OIL, GAS OR WATER RECORDS

### CASING RECORD

Formation	Content	From	To	Size	Put In	Pulled Out
				8-5/8"	320'	

Describe in detail the manner in which the well was plugged, indicating where the mud fluid was placed and the method or methods used in introducing it into the hole. If cement or other plugs were used, state the character of same and depth placed, from feet to feet for each plug set.

Cemented plug at 275' with 15 Sacks Cement.

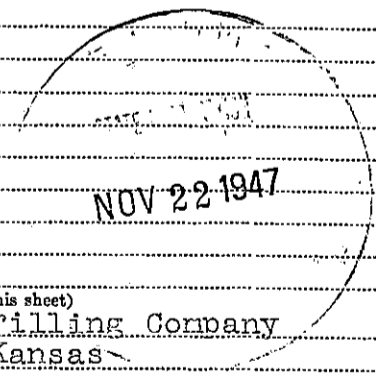

(If additional description is necessary, use BACK of this sheet)  
 Correspondence regarding this well should be addressed to Sterling Drilling Company  
 Address Sterling, Kansas

STATE OF Kansas, COUNTY OF Rice, ss.  
 Rollin Mead (employee of owner) or (owner or operator) of the above-described well,  
 being first duly sworn on oath, says: That I have knowledge of the facts, statements, and matters herein contained and the log of the above-described well as filed and that the same are true and correct. So help me God.

(Signature) *Rollin Mead*  
 Sterling, Kansas (Address)

SUBSCRIBED AND SWORN to before me this 20th day of November, 1947

My commission expires September 17, 1949.

*J. A. Unwell*  
 Notary Public.

**PLUGGING**  
 FILE SEC 19 T 28 R 9 W  
 BOOK PAGE 141 LINE 7

15-095-01531-000

Location - Center of the E/2 of the SE/4 of Section 19-28S-9W, Kingman County, Kansas.

Owner - Globe Oil & Refining Co.

Contractor - Sterling Drilling Company

Commenced - September 23, 1947

Completed - October 12, 1947

Total Depth - 4405' (Ground Elevation)

Casing Record

320' 8-5/8" Surface Pipe  
Cemented with 300 Sacks Cement

LOG

0- 160	Surface
160- 400	Red Bed
400- 810	Shale
810- 835	Anhydrite
835-1000	Shale & Shells
1000-1250	Salt
1250-1400	Salt & Shale
1400-1645	Shale & Lime
1645-1905	Lime
1905-2365	Shale & Lime
2365-2570	Shale & Shells
2570-2750	Shale & Lime
2750-2780	Lime
2780-2820	Lime & Shale
2820-3260	Lime
3260-3360	Lime & Shale
3360-3445	Lime
3445-3530	Lime & Shale
3530-3795	Lime
3795-3825	Lime & Shale
3825-3895	Lime
3895-3965	Lime & Shale
3965-4005	Broken Lime
4005-4045	Lime & Shale
4045-4130	Lime
4130-4170	Chatt
4170-4177	Lime
4177-4402	Shale
4402-4410	Lime
4410	Total Depth

Production

None - - - - - Dry

**PLUGGING**  
 WELL SEC 19-28-9W  
 DEEP 146 LUG 9