


WELL PLUGGING RECORD

Give All Information Completely
Make Required Affidavit
Mail or Deliver Report to:
Conservation Division
State Corporation Commission
800 Bitting Building
Wichita, Kansas

NORTH

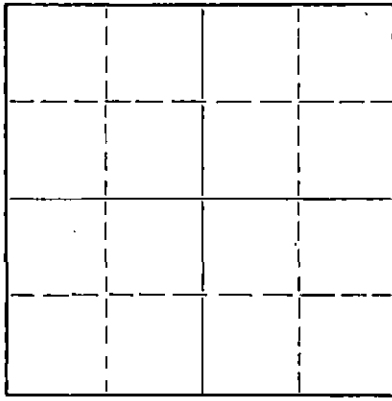

Locate well correctly on above Section Plat

Kingman County, Sec. 23 Twp. 28 Rge. 8 (X) (W)
Location as "NE/CNW/SW" or footage from lines SW SW SW
Lease Owner Petroleum, Inc.
Lease Name DILLON Well No. 1
Office Address 311 East Third, Wichita, Kansas
Character of Well (completed as Oil, Gas or Dry Hole) Dry Hole
Date well completed December 2, 19 54
Application for plugging filed December 2, 19 54
Application for plugging approved December 2, 19 54
Plugging commenced December 2, 19 54
Plugging completed December 2, 19 54
Reason for abandonment of well or producing formation _____

Dry Hole

If a producing well is abandoned, date of last production _____ 19 _____
Was permission obtained from the Conservation Division or its agents before plugging was commenced? Yes

Name of Conservation Agent who supervised plugging of this well Mr. Ruel Durkee
Producing formation _____ Depth to top _____ Bottom _____ Total Depth of Well 4620 Feet
Show depth and thickness of all water, oil and gas formations.

OIL, GAS OR WATER RECORDS

CASING RECORD

FORMATION	CONTENT	FROM	TO	SIZE	PUT IN	PULLED OUT
				8-5/8"	204'	None

Describe in detail the manner in which the well was plugged, indicating where the mud fluid was placed and the method or methods used in introducing it into the hole. If cement or other plugs were used, state the character of same and depth placed, from _____ feet to _____ feet for each plug set.

Run 1 1/2" drill pipe to bottom. Gun pits and
mix 12# mud. Lay down 1/2 of drill pipe, then break circulation
and fill hole with 12# mud. Lay down all but seven joints of
remaining drill pipe and set wooden plug at 200# and bridge to hold
seven joints of drill pipe. Lay down 1 joint of drill pipe and mix
20 sacks cement and displace through drill pipe on top of plug.
Mudded up with heavy mud to 20' and set second wooden plug at 20'
tied with wire line. Mixed 5 sacks cement and poured down surface
pipe. Cement to bottom of well cellar.

(If additional description is necessary, use BACK of this sheet)

Name of Plugging Contractor Garvey Drilling Company
Address R.R. #2 - Great Bend, Kansas

STATE OF KANSAS, COUNTY OF SEDGWICK, ss.
Karl E. Becker (employee of owner) of the above-described well, being first duly sworn on oath, says: That I have knowledge of the facts, statements, and matters herein contained and the log of the above-described well as filed and that the same are true and correct. So help me God.

(Signature) Karl E. Becker
311 East Third, Wichita, Kansas
(Address)

SUBSCRIBED AND SWORN to before me this 6th day of December, 19 54

My commission expires 8-11-58

Notary Public.

PLUGGING
FILE SEC 23 T 28 R 8W
BOOK PAGE 82 LINE 4

RCUP
12-16-54

WELL LOG

15-095-00401-0000

COMPANY **Petroleum, Inc.**

SEC. 23 T. 28S R. 8W

FARM **DILLON**

NO. 1

LOC. SW SW SW


TOTAL DEPTH **4620'**

COUNTY **Kingman County, Kansas**

COMM. **November 14, 1954.**

COMP. **December 1, 1954.**

CONTRACTOR **Garvey Drilling Company**

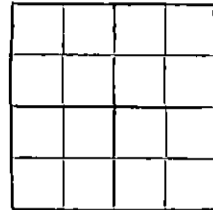

CASING **8-5/8" @ 204' w/150 sax.**

ELEVATION **1626' RB**

PRODUCTION **D & A**

FIGURES INDICATE BOTTOM OF FORMATIONS

600	Red Bed
1160	Shale & Shells
1200	Anhydrite
1520	Lime & Shale
1580	Shale
1715	Lime
1875	Lime & Shale
2005	Lime
2155	Lime & Shale
2415	Shale
2570	Shale & Shells
2950	Lime & Shale
3100	Lime
3200	Shale & Sand
3265	Sand
3285	Lime & Shale
3350	Sand & Shale
3384	Sand
4125	Lime
4158	Chert
4170	Lime
4195	Lime & Chert
4270	Lime
4425	Lime & Shale
4440	Chert
4475	Lime & Shale
4520	Sand & Shale
4544	Shale
4620	Shale & Lime
4620	T.D.

Tops:

Douglas Sand: 3194 (-1568)
 Lansing: 3383 (-1757)
 Mississippi: 4087 (-2461)
 Kinderhook: 4276 (-2650)
 Viola: 4424 (-2798)
 Simpson Shale: 4515 (-2889)
 Arbuckle: 4577 (-2951)

State of KANSAS }
 County of SEDGWICK } ss:

I, Karl E. Becker of Petroleum, Inc.

upon oath state that the above and foregoing is a true and correct copy of the log of the DILLON #1 well.

Karl E. Becker

Subscribed and sworn to before me this 14th day of December, 1954.

My Commission Expires: 8-11-58
PLUGGING
 FRI SEC 2128
 COCK PAGE 12 LINE 4

[Signature]
 NOTARY PUBLIC