

15-095-01012-000


STATE OF KANSAS
STATE CORPORATION COMMISSION

Form CP-4

Give All Information Completely
Make Required Affidavit
Mail or Deliver Report to:
Conservation Division
State Corporation Commission
212 No. Market
Wichita, Kansas

WELL PLUGGING RECORD

NORTH

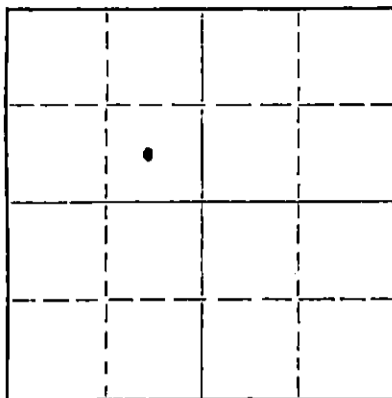

Locate well correctly on above
Section Plat

Kingman County. Sec. 24 Twp. 28S Rge. 8 (E) W (W)
Location as "NE/CNW%SW%" or footage from lines C NW SE
Lease Owner Stelbar Oil Corporation, Inc.
Lease Name Garlish Well No. 1
Office Address 310 Petroleum Bldg. Wichita, Kansas
Character of Well (completed as Oil, Gas or Dry Hole) Dry Hole
Date well completed 10-8 19 66
Application for plugging filed 10-8 19 66
Application for plugging approved 10-8 19 66
Plugging commenced 10-8 19 66
Plugging completed 10-8 19 66
Reason for abandonment of well or producing formation Dry Hole

If a producing well is abandoned, date of last production _____ 19____
Was permission obtained from the Conservation Division or its agents before plugging was commenced? Yes

Name of Conservation Agent who supervised plugging of this well Archie Ewing, Pratt, Kansas
Producing formation _____ Depth to top _____ Bottom _____ Total Depth of Well 4465 Feet
Show depth and thickness of all water, oil and gas formations.

OIL, GAS OR WATER RECORDS

CASING RECORD

FORMATION	CONTENT	FROM	TO	SIZE	PUT IN	PULLED OUT
Surface Pipe		-0-	261	8 5/8"	261	-0-

Describe in detail the manner in which the well was plugged, indicating where the mud fluid was placed and the method or methods used in introducing it into the hole. If cement or other plugs were used, state the character of same and depth placed, from _____ feet to _____ feet for each plug set.

Filled hole with heavy mud.
#1 plug at 250' w/ 25 sks. cement
#2 plug at 40' w/ 10 sks. cement
#3 plug in rathole w/2 sks. cement

RECEIVED
STATE CORPORATION COMMISSION
OCT 18 1966
CONSERVATION DIVISION
WICHITA, KANSAS

(If additional description is necessary, use BACK of this sheet)

Name of Plugging Contractor S & S Drilling Company
Address Box 645 Great Bend, Kansas 67530

STATE OF Kansas, COUNTY OF Barton, ss.
T. D. Sweetman (employee of owner) or (owner or operator) of the above-described well, being first duly sworn on oath, says: That I have knowledge of the facts, statements, and matters herein contained and the log of the above-described well as filed and that the same are true and correct. So help me God.

(Signature) T. D. Sweetman
Box 645, Great Bend, Kansas 67530
(Address)

SUBSCRIBED AND SWORN TO before me this 11 day of October, 19 66

My commission expires 5/9/67
Heath Boyd Notary Public.

1509501012-0000

WELL LOG
Carlish # 1
C NW SE 24- 28S-2W
Kingman County, Kansas

FROM	TO		Formation Tops:
0	60	Sand	Meebaer 3127'
90	1140	Red Red & Shells	Brown Lime 3369'
1140	1740	Shale & Lime	Lansing 3380'
1740	1900	Lime	Base K. C. 3843'
1900	2360	Shale & Lime	Mississippi 4032'
2360	3586	Lime	K. H. 4292'
3586	4031	Lime & Shale	Viola 4439'
4031	4290	Lime	Simpson 4459'
4290	4463	Lime & Shale	T.D. 4463'
4463		Total Depth	

RECEIVED
STATE CORPORATION COMMISSION
OCT 12 1966
CONSERVATION DIVISION
Wichita, Kansas

STATE OF KANSAS

COUNTY OF BARTON ss

T. D. Sweetman, Partner of S & S Drilling Company, being first duly sworn on oath says: That I have knowledge of the facts, statements and matters herein contained and the log of the above described well as filed and that the same are true and correct.

T. D. Sweetman
T. D. Sweetman

Subscribed and sworn before me this 10th day of October, 1966.

Robert L. Boyd
Notary Public Barton County

My Commission Expires 5/9/67