


WELL PLUGGING RECORD

Give All Information Completely
Make Required Affidavit
Mail or Deliver Report to:
Conservation Division
State Corporation Commission
212 No. Market
Wichita, Kansas

Kingman County, Sec. 24 Twp. 28 Rge. 8 (E) (W)
Location as "NE/CNW/SE/SW" or footage from lines C SW NW
Lease Owner: K & E Drilling Company
Lease Name: Garlich A#1 Well No. _____
Office Address: Wichita, Kansas
Character of Well (completed as Oil, Gas or Dry Hole) _____
Date well completed _____ 19____
Application for plugging filed _____ 19____
Application for plugging approved _____ 19____
Plugging commenced 5/12/69 _____ 19____
Plugging completed 5/14/69 _____ 19____
Reason for abandonment of well or producing formation depleted.

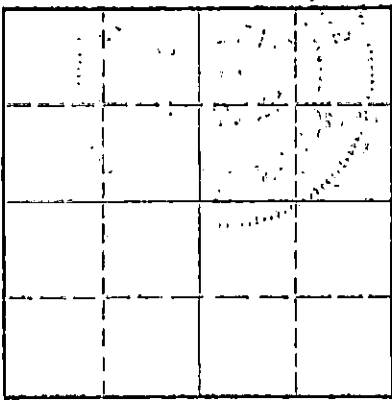

Locate well correctly on above Section Plat

If a producing well is abandoned, date of last production _____ 19____
Was permission obtained from the Conservation Division or its agents before plugging was commenced? yes

Name of Conservation Agent who supervised plugging of this well Warren
Producing formation _____ Depth to top _____ Bottom _____ Total Depth of Well 4433 Feet
Show depth and thickness of all water, oil and gas formations.

OIL, GAS OR WATER RECORDS

CASING RECORD

FORMATION	CONTENT	FROM	TO	SIZE	PUT IN	PULLED OUT
				8-5/8	260	none
				4 1/2"	4432 1/2'	3495'

STATE RECEIVED
CORPORATION COMMISSION
MAY 28 1969
CONSERVATION DIVISION
Wichita, Kansas

Describe in detail the manner in which the well was plugged, indicating where the mud fluid was placed and the method or methods used in introducing it into the hole. If cement or other plugs were used, state the character of same and depth placed, from _____ feet to _____ feet for each plug set.


Checked bottom, ransand to 3700', dumped 4 sacks of cement.
Loaded hole, shot pipe at 3518', worked pipe loose and pulled 106 joints of 4 1/2". Bailed hole to 260', set 10' rock bridge and dumped 25 sacks of cement. Mudded to 40' rock bridge, dumped 10 sacks of cement. Tallied pipe.

PLUGGING COMPLETE.

(If additional description is necessary, use BACK of this sheet)
Name of Plugging Contractor: KNIGHT CASING PULLING CO., INC.
Address: CHASE, KANSAS

STATE OF KANSAS COUNTY OF RICE, ss.
NOEL J. KNIGHT (employee of owner) or (owner or operator) of the above-described well, being first duly sworn on oath, says: That I have knowledge of the facts, statements, and matters herein contained and the log of the above-described well as filed and that the same are true and correct. So help me God.

(Signature) Noel Knight
CHASE, KANSAS
(Address)

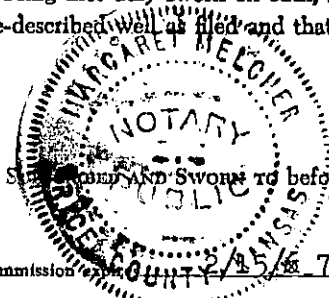

Subscribed and Sworn to before me this 19th day of May, 1969
My commission expires 2/15/71
Margaret Melcher Notary Public.

SP 15-095-30104-0000

DRILLER'S WELL LOG

OPERATOR: K & E DRILLING, INC.

WELL NAME: #1 Garlisch "A"

LOCATION: Center SW/4 NW/4
Section 24-28S-8W
Kingman County, Kansas

CONTRACTOR: **K & E DRILLING, INC.**
Company Tools **719 UNION CENTER BLDG.**
WICHITA, KANSAS

CASING RECORD:
8-5/8" @ 260'
4-1/2" @ 4434-1/2'

COMMENCED: 6-1-66
COMPLETED: 6-15-66
ELEVATION: 1635' Grd; 1641' DF;
1644' KB
PRODUCTION: Oil

ROTARY TOTAL DEPTH: 4437'

FORMATION RECORD

Depths shown indicate bottom of formations encountered.

Sand	90
Red Bed & Shale	259
Shale & Shells	1430
Lime & Shale	1795
Lime	2065
Shale & Shells	2355
Shale & Lime	2510
Lime	3262
Sand & Lime	3392
Lime	3812
Lime Hd.	3865
Lime	4080
Chert	4100
Chert & Lime	4135
Lime	4275
Shale & Lime	4347
Lime	4384
Lime & Shale	4415
Lime	4437

RECEIVED
STATE CORPORATION COMMISSION
JAN 22 1969
CONSERVATION DIVISION
Wichita, Kansas

CERTIFICATION

State of KANSAS
County of SEDGWICK ss:

I, Wayne L. Brinegar, of K&E DRILLING, INC., upon oath state that the above and foregoing is a true and correct copy of the Driller's Log of the above named well.

Subscribed and sworn to before me this 27th day of June 1966

Wayne L. Brinegar
Wayne L. Brinegar
Judie Bickford
Judie Bickford Notary Public.

Notary expires: 6-8-70



K & E DRILLING, INC.



Rotary Drilling Contractors