

WELL PLUGGING RECORD

Give All Information Completely
Make Required Affidavit
Mail or Deliver Report to:
Conservation Division
State Corporation Commission
212 North Market, Insurance Bldg.
Wichita, Kansas

Kingman

County, Sec. 25 Twp. 28S Rge. (E) 8 (W)

Location as "NE/CNW/SW" or footage from lines C-NE $\frac{1}{4}$ -NE $\frac{1}{4}$ -NW $\frac{1}{4}$

Lease Owner Amerada Petroleum Corporation

Lease Name R. Henning Well No. 1

Office Address Box 194, Great Bend, Kansas

Character of Well (completed as Oil, Gas or Dry Hole) DRY

Date well completed 3-27- 19 62

Application for plugging filed Verbal 3-27- 19 62

Application for plugging approved 3-27- 19 62


Plugging commenced 3-27- 19 62

Plugging completed 3-27- 19 62

Reason for abandonment of well or producing formation DRY

If a producing well is abandoned, date of last production - 19

Was permission obtained from the Conservation Division or its agents before plugging was commenced? Yes

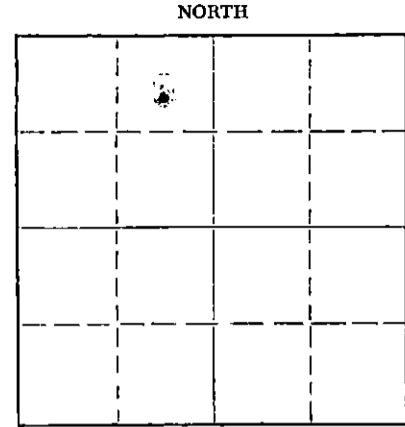

Locate well correctly on above Section Plat

Name of Conservation Agent who supervised plugging of this well Fred W. Hampel, Pretty Prairie, Kansas

Producing formation - Depth to top - Bottom - Total Depth of Well 4479 Feet

Show depth and thickness of all water, oil and gas formations.

OIL, GAS OR WATER RECORDS

CASING RECORD

FORMATION	CONTENT	FROM	TO	SIZE	PUT IN	PULLED OUT
				8-5/8" OD	268'	None

Describe in detail the manner in which the well was plugged, indicating where the mud fluid was placed and the method or methods used in introducing it into the hole. If cement or other plugs were used, state the character of same and depth placed, from _____ feet to _____ feet for each plug set.

Filled hole with heavy mud from 4479' to 260'

Spotted Cement Plug from 260' to 40' W/20 Sacks Cement By Halliburton

Spotted Cement Plug from 40' to Top W/20 Sacks Cement By Halliburton

RECEIVED
STATE CORPORATION COMMISSION

04-13-62

APR 13 1962

CONSERVATION DIVISION
WICHITA, KANSAS

(If additional description is necessary, use BACK of this sheet)

Name of Plugging Contractor Amerada Petroleum Corporation (License No. 81)

Address Box 197, Great Bend, Kansas

STATE OF Kansas, COUNTY OF Barton, ss.

A.D. Simpson (employee of owner) of the above-described well, being first duly sworn on oath, says: That I have knowledge of the facts, statements, and matters herein contained and the log of the above-described well as filed and that the same are true and correct. So help me God.

(Signature) A.D. Simpson

Box 197, Great Bend, Kansas (Address)

SUBSCRIBED AND SWORN TO before me this 10th day of April 19 62

Charles W. Anderson
Charles W. Anderson Notary Public.

My commission expires November 21, 1965



LOG

Farm: Henning
Well No. 1
NE NE NW Sec. 25-28S-8W
Kingman County, Kansas

Drilling Commenced: 3-8-62
Drilling Completed: 3-27-62
Owner: Amerada Petroleum Corporation
Contractor: Stelbar Oil Corporation, Inc.

268' 8-5/8" cemented with 200 sacks
Elevation: 1644 K.B.

0	65	Sand and Clay
65	147	Sand
147	275	Shale and Shells
275	660	Red Rock Shale
660	1460	Shale and Shells
1460	2805	Shale and Lime
2805	2982	Lime
2982	3182	Lime and Shale
3182	3224	Douglas Sand
3224	3345	Sand
3345	3940	Lime
3940	4091	Lime and Shale
4091	4221	Mississippi Lime
4221	4294	Lime
4294	4356	Shale and Lime
4356	4433	Shale
4433	4449	Viola
4449	4479	Simpson Sand
	4479	RTD, D & A

RECEIVED
STATE CORPORATION COMMISSION
APR 13 1962
CONSERVATION DIVISION
Wichita, Kansas

Filled with mud to 260', set plug and dumped 20 sacks cement;
filled with mud to 40', set plug and dumped 15 sacks cement.

I certify this to be a true copy of the Driller's log.

Leona Hargrove
Leona Hargrove, Notary Public

My commission expires:
January 18, 1964