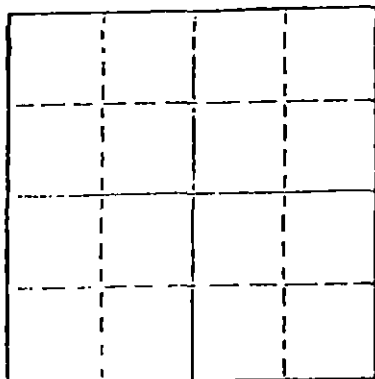


STATE OF KANSAS
STATE CORPORATION COMMISSION

WELL PLUGGING RECORD

Give All Information Completely
Make Required Affidavit
Mail or Deliver Report to
Conservation Division
State Corporation Comm.
245 North Water
Wichita, KS 67202

Locate well correctly on above
Section Plot

Kingman County. Sec. 32 Twp. 28S Rge. 8W E/W
Location as "NE/CNW $\frac{1}{4}$ SW $\frac{1}{4}$ " or footage from lines

SE NW SW

Lease Owner Keener Oil Company

Lease Name William Osner Well No. 1

Office Address 406 Nat'l Bank of Tulsa Bldg. Tulsa Okl.

Character of Well (Completed as Oil, Gas or Dry Hole) 74103

Dry Hole

Date Well completed October 2, 1977

Application for plugging filed Verbal Application 1977

Application for plugging approved Verbal Approval 1977

Plugging commenced October 2, 1977

Plugging completed October 2, 1977

Reason for abandonment of well or producing formation

If a producing well is abandoned, date of last production
19

Was permission obtained from the Conservation Division or
its agents before plugging was commenced? Yes

Name of Conservation Agent who supervised plugging of this well William T. Owen

Producing formation Depth to top Bottom Total Depth of Well 4,134

Show depth and thickness of all water, oil and gas formations.

STATE CO.

RWD

OIL, GAS OR WATER RECORDS 7 10-06-77

CASING RECORD

FORMATION	CONTENT	FROM	TO	SIZE	PUT IN	PULLED OUT
CONSERVATION DIVISION Wichita, Kansas	DAVIS ON KNSCS			8 5/8"	216'	None

Describe in detail the manner in which the well was plugged, indicating where the mud fluid was placed and the method or methods used in introducing it into the hold. If cement or other plugs were used, state the character of same and depth placed, from feet to feet for each plug set.

Filled Hole with Heavy rotary mud from 4,134 ft. (rotary total depth) to 220 ft. Set plug at 220 ft. and cemented with 35 sacks cement.

Filled hole with heavy rotary mud from 220 ft. to 40 ft. Set solid plug at 40 ft. and cemented to cellar with 12 sacks cement, 3 sacks cement in rat hole.

Plugging operations accomplished utilizing Halliburton Oil Well cementing pump truck through 4 1/2 inch drill pipe.

(If additional description is necessary, use BACK of this sheet)

Name of Plugging Contractor Halliburton Services

410 Union Center Bldg. Wichita, Ks. 67202

STATE OF Kansas COUNTY OF Sedgwick, ss.

Dean Britting - Agent

(Owner) or XXXXXXXXXXXXXXX

of the above-described well, being first duly sworn on oath, says: That I have knowledge of the facts, statements, and matters herein contained and the log of the above-described well as filed and that the same are true and correct. So help me God.

(Signature)

Dean Britting

200 N. Main Wichita, Ks 67202

(Address)

SUBSCRIBED AND SWORN TO before me this 5th day of October, 1977

My commission expires June 30, 1978

Elsie Willison

Notary Public.

API# 15-095-20,633
- 0000

KANSAS GEOLOGICAL SOCIETY
KANSAS WELL LOG BUREAU - KANSAS WELL SAMPLE BUREAU
KANSAS GEOLOGICAL SOCIETY BUILDING
508 EAST MURDOCK - WICHITA, KANSAS

COMPANY Keener Oil Company

SEC. 32 T. 28S R. 8W
LOC. SE NW SW

FARM William Osner NO. 1

TOTAL DEPTH 4,134'


COUNTY Kingman
KANSAS

COMM. September 22, 1977 COMP. October 2, 1977

SHOT OR TREATED

CONTRACTOR H-30, Inc.

ISSUED October 5, 1977

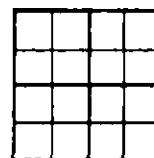

CASING

20	10	
15	8 5/8"	216' cemented w/ 175 sxs cement
12	6	
13	5	

ELEVATION 1,925 K.B.

PRODUCTION

FIGURES INDICATE BOTTOM OF FORMATIONS

Sand and Red Bed	270'
Red Bed and Shale	1,430'
Shale and Lime	1,590'
Lime and Shale	3,407'
Lime	3,535'
Lime and Shale	4,025'
Lime	4,127'
Chert	4,134'
Rotary Total Depth	4,134'

RECEIVED
OCT 06 1977
COUNTY OF KINGMAN
WICHITA, KANSAS

I hereby certify the above and foregoing to be
a true and correct log of the above described
well as shown by the drilling reports.

H-30, Inc.

Dean Britting
Dean Britting

State of Kansas }
County of Sedgwick } ss:

Subscribed and Sworn to before me a Notary Public
in and for said county and State this 5th day of
October, 1977

Elsie Willison
Elsie Willison - Notary Public

My Commission Expires:

June 30, 1978

