


STATE OF KANSAS
STATE CORPORATION COMMISSION

Give All Information Completely
Make Required Affidavit
Mail or Deliver Report to:
Conservation Division
State Corporation Commission
211 No. Broadway
Wichita, Kansas

WELL PLUGGING RECORD

NORTH

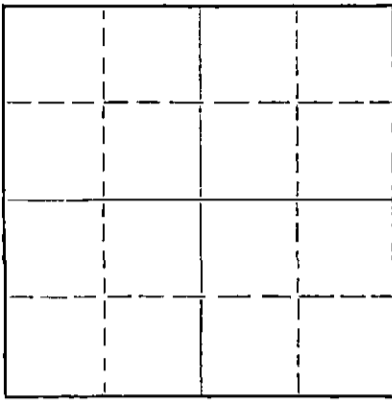

Locate well correctly on above
Section Plat

Hodgeman County. Sec. 3 Twp. 24S Rge. (E) 22(W)
Location as "NE/CNW/SW" or footage from lines. C SW NE
Lease Owner Halo Oil Producers, Inc.
Lease Name Hall Well No. 1
Office Address 3130 Linden Avenue Long Beach, California
Character of Well (completed as Oil, Gas or Dry Hole) Dry Hole
Date well completed July 29 1958
Application for plugging filed July 28 1958
Application for plugging approved July 29 1958
Plugging commenced July 29 1958
Plugging completed July 29 1958
Reason for abandonment of well or producing formation Dry Hole

If a producing well is abandoned, date of last production N/A 19
Was permission obtained from the Conservation Division or its agents before plugging was commenced? Yes

Name of Conservation Agent who supervised plugging of this well Don Peterson
Producing formation _____ Depth to top _____ Bottom _____ Total Depth of Well 4750 Feet
Show depth and thickness of all water, oil and gas formations.

OIL, GAS OR WATER RECORDS

CASING RECORD

FORMATION	CONTENT	FROM	TO	SIZE	PUT IN	PULLED OUT
		0	0	8-5/8"	407'	None

Describe in detail the manner in which the well was plugged, indicating where the mud fluid was placed and the method or methods used in introducing it into the hole. If cement or other plugs were used, state the character of same and depth placed, from _____ feet to _____ feet for each plug set.
Set bottom plug on fluid @ 400' w/20 sacks cement through drill pipe.
Mud to 30', set top plug w/1/3 sx hull & 10 sx cement. Cement to
Bottom of cellar.

RECEIVED
STATE CORPORATION COMMISSION
FEB 20 1959
CONSERVATION DIVISION
WICHITA, KANSAS

(If additional description is necessary, use BACK of this sheet)
Name of Plugging Contractor Graham Michaelis Drilling Company
Address 211 North Broadway Wichita 2, Kansas

STATE OF KANSAS COUNTY OF SEDGWICK, ss.
O. W. Woodland (employee of owner) or ~~(owner or operator)~~ of the above-described well, being first duly sworn on oath, says: That I have knowledge of the facts, statements, and matters herein contained and the log of the above-described well as filed and that the same are true and correct. So help me God.

(Signature) [Signature]
211 North Broadway Wichita 2, Ks.
(Address)

SUBSCRIBED AND SWORN TO before me this 4th day of August, 1958

[Signature]
E. Gene Byrd Notary Public.

My commission expires December 14, 1961

PLUGGING
FILE SEC 3 T. 24 R. 22W
BOOK PAGE 120 LINE 20

HALL-HALO #1

WELL RECORD

LOCATION: SW NE Sec. 3-T24S-R22W Commenced: 7/9/58
 Hodgeman County, Kansas Completed: 7/29/58

OPERATOR: Halo Oil Producers, Inc.
 3130 Linden Avenue
 Long Beach, California

CONTRACTOR: Graham Michaelis Drilling Company
 211 North Broadway
 Wichita 2, Kansas

CASING RECORD: 8-5/8" @ 407' w/200 sx, 2% cc & 2% gel

LOG

Surface Rock	35'
Shale	156
Red Bed & Lime	543
Shale	1085
Shale & Lime	2085
Shale, Anhy & Lime	2310
Lime & Shale	2547
Lime	3825
Shale & Lime	3961
Lime	4103
Lime & Shale	4640
Chert & Lime	4656 RTD

RECEIVED
 STATE OF KANSAS
 CONSERVATION DIVISION
 FEB 18 1959
 Wichita, Kansas

STATE OF KANSAS)
) ss.
 COUNTY OF SEDGWICK)

The undersigned, GRAHAM-MICHAELIS DRILLING COMPANY, hereby certifies that the above log is a true and correct log of the formations encountered in drilling the above well as reflected by the Daily Drilling Report.

GRAHAM-MICHAELIS DRILLING COMPANY

By Jack L. Ginger
 Geologist

Subscribed and sworn to before me
 this 4th day of August, 1958

E. Gene Dyrd
 Notary Public
 My commission expires 12/14/61

PLUGGING
 FILE SEC. 3 T. 24 R. 22W
 BOOK PAGE 120 LINE 20

HALL-HALO #1

WELL RECORD

LOCATION: SW NE Sec. 3-T24S-R22W Commenced: 7/9/58
 Lodgeman County, Kansas Completed: 7/21/58

OPERATOR: Halo Oil Producers, Inc.
 3100 Linden Avenue
 Long Beach, California

CONTRACTOR: Graham-Michaelis Drilling Company
 211 North Broadway
 Wichita 2, Kansas

CASING RECORD: 3-5/8" x 407' w/200' ex, 5/8" cc & 3/4" gal

LOG

Surface Rock	35'
Shale	156
Red Bed & Lino	313
Shale	1085
Shale & Lime	2025
Shale, Anhy & Lino	2510
Lime & Shale	2647
Lime	2825
Shale & Lime	3601
Lime	4103
Lime & Shale	4640
Chert & Lime	4656 RTD

RECEIVED
 STATE CONSERVATION COMMISSION
 FEB 18 1959
 CONSERVATION DIVISION
 Wichita, Kansas

STATE OF KANSAS)
) ss.
 COUNTY OF SEDGWICK)

The undersigned, GRAHAM-MICHAELIS DRILLING COMPANY, hereby certifies that the above log is a true and correct log of the formations encountered in drilling the above well as reflected by the daily drilling report.

GRAHAM-MICHAELIS DRILLING COMPANY

By Jack L. Ginger
 Geologist

Subscribed and sworn to before me
 this 4th day of August, 1958

 M. Gene Byrd Notary Public
 My commission expires 10/14/61