


STATE OF KANSAS
STATE CORPORATION COMMISSION

WELL PLUGGING RECORD

Give All Information Completely
Make Required Affidavit
Mail or Deliver Report to
Conservation Division
State Corporation Comm.
245 North Water
Wichita, KS 67202

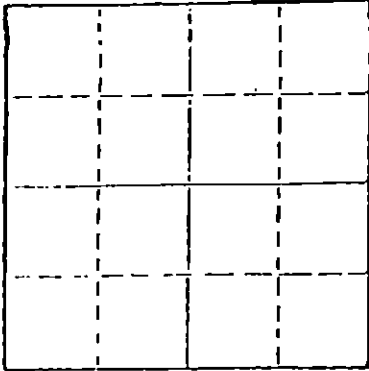

Locate well correctly on above
Section Plot

Edwards County, Sec. 31 Twp. 24S Rge. 17W E/W
Location as "NE/CNW $\frac{1}{4}$ SW $\frac{1}{4}$ " or footage from lines
SW SW

Lease Owner Imperial Oil Co.
Lease Name Wiltgen #1-31 Well No. _____
Office Address Box 784, Great Bend, Ks. 67530
Character of Well (Completed as Oil, Gas or Dry Hole) _____

Date Well completed _____ 19____
Application for plugging filed _____ 19____
Application for plugging approved _____ 19____
Plugging commenced 2/23/81 _____ 19____
Plugging completed 2/26/81 _____ 19____
Reason for abandonment of well or producing formation
Depleted

If a producing well is abandoned, date of last production
_____ 19____

Was permission obtained from the Conservation Division or
its agents before plugging was commenced? Yes

Name of Conservation Agent who supervised plugging of this well Maurice Leslie
Producing formation _____ Depth to top _____ Bottom _____ Total Depth of Well 4645
Show depth and thickness of all water, oil and gas formations.

OIL, GAS OR WATER RECORDS

CASING RECORD

FORMATION	CONTENT	FROM	TO	SIZE	PUT IN	PULLED OUT
				8-5/8"	608	None
				4-1/2"	2882	2328'

Describe in detail the manner in which the well was plugged, indicating where the mud fluid
was placed and the method or methods used in introducing it into the hold. If cement or other
plugs were used, state the character of same and depth placed, from _____ feet to
_____ feet for each plug set.

Made bottom hole plug back with sand to 2750. Ran 4 sacks cement thru dump baler. Made
shot at 2315. Pulled total of 57 joints. Squeezed hole with 15 sacks gel, 6 sacks hulls
and 10 sacks gel. Released plug and displaced with 125 sacks 50/50 pos 4% gel 3% cc.
Plugging complete.

3-4-81

(If additional description is necessary, use BACK of this sheet)

Name of Plugging Contractor KELSO CASING PULLING
CHASE, KANSAS

MAR - 4 1981

STATE OF Kansas COUNTY OF Rice
R. Darrell Kelso (employee of owner) or (owner or operator)

of the above-described well, being first duly sworn on oath, says: That I have knowledge of
the facts, statements, and matters herein contained and the log of the above-described well
as filed and that the same are true and correct. So help me God.

(Signature) R. Darrell Kelso
Chase, Kansas (Address)

SUBSCRIBED AND SWORN TO before me this 3rd day of March, 1981

My commission expires



Joan Kelso
Notary Public.