


WELL PLUGGING RECORD

Give Information Completely  
Make Required Affidavit  
Mail or Deliver Report to:  
Conservation Division  
State Corporation Commission  
800 Biting Building  
Wichita, Kansas

NORTH

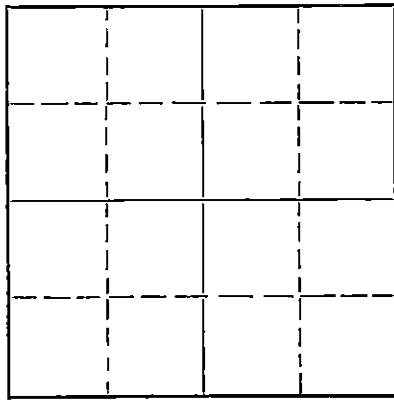

Locate well correctly on above  
Section Plat

Edwards County. Sec. 27 Twp. 24 Rge. 19 (E) (W)  
Location as "NE/CNW\*SW\*" or footage from lines NW SE NW  
Lease Owner H. F. Thompson, et al  
Lease Name Copp Well No. 1  
Office Address Ellinwood  
Character of Well (completed as Oil, Gas or Dry Hole) Dry Hole  
Date well completed October 27, 1953 19  
Application for plugging filed October 26, 1953 19  
Application for plugging approved October 26, 1953 19  
Plugging commenced October 27, 1953 19  
Plugging completed October 27, 1953 19  
Reason for abandonment of well or producing formation Dry

If a producing well is abandoned, date of last production \_\_\_\_\_ 19\_\_\_\_  
Was permission obtained from the Conservation Division or its agents before plugging was commenced? Yes

Name of Conservation Agent who supervised plugging of this well C. D. Stough  
Producing formation \_\_\_\_\_ Depth to top \_\_\_\_\_ Bottom \_\_\_\_\_ Total Depth of Well 4560 Feet  
Show depth and thickness of all water, oil and gas formations.

OIL, GAS OR WATER RECORDS

CASING RECORD

FORMATION	CONTENT	FROM	TO	SIZE	PUT IN	PULLED OUT

Describe in detail the manner in which the well was plugged, indicating where the mud fluid was placed and the method or methods used in introducing it into the hole. If cement or other plugs were used, state the character of same and depth placed, from \_\_\_\_\_ feet to \_\_\_\_\_ feet for each plug set.

20 sacks cement at 270' and 10 sacks and plug at 48'

11-4-53

(If additional description is necessary, use BACK of this sheet)

Name of Plugging Contractor Greenland Drilling Company  
Address 506 Union National Bank Bldg. Wichita, Ks.


STATE OF KANSAS, COUNTY OF SEDGWICK, ss.  
Richard S. Davis (employee of owner) or (owner or operator) of the above-described well, being first duly sworn on oath, says: That I have knowledge of the facts, statements, and matters herein contained and the log of the above-described well as filed and that the same are true and correct. So help me God.

(Signature) [Signature]  
Wichita, Kansas (Address)

SUBSCRIBED AND SWORN TO before me this 30 day of October, 19 53

[Signature]  
Notary Public.

My commission expires 7-8-57

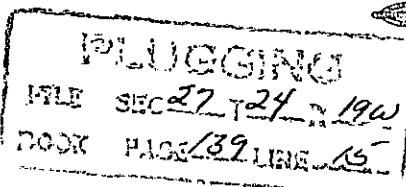

WELL LOG

Lease Owner: H. F. Thompson and associates  
 Contractor: Greenland Drilling Company  
 Farm: Copp Well #1  
 Total Depth: 4560'  
 Comm: 10-12-53  
 Comp: 10-27-53  
 Casings: 276' of 8 5/8" w/250 sks. cement

Sec. 27 T 24S R 19W  
 Loc. NW SE NW  
 County: Edwards  
 Elevation: 2160 DF  
 Production: D & A

Figures Indicate Bottom of Formations

130	sand & clay	TOPS	
190	sand stone & shale	Feb.	3876
205	sand	Tronto	3900
276	shale & shells	Br. Line	3987
525	shale	Lans.	3996
950	sand w/sh & red bed	B. K. C.	4321
1300	red bed	Miss. Chert	4546-68 TD
1340	Anhy.		
1730	shale & lime & shells		
2025	shale & lime		
2260	lined shale		
2470	lime w/sh. brks.		
2892	lime & shale		
2912	sand & shale		
3200	shaled lime		
3299	shale		
3550	lime & shale		
3619	lime w/sh. brks.		
3939	lined shale		
3987	shale & pyrite w/sd.		
3993	Br. lime		
3997	shals		
4024	lan. lime		
4059	lime & shale		
4316	lime		
4560	lime & shale		

RECEIVED  
 STATE DEPARTMENT OF REVENUE  
 NOV 15 1953  
 CONSTRUCTION DIVISION  
 Topeka, Kansas

State of Kansas )  
 County of Sedgwick)ss.

I, Richard S. Davis of the Greenland Drilling Company upon oath state that the above and foregoing is a true and correct copy of the log of the Copp #1 well.

**PLUGGING**  
 FILE SEC 27 T 24 R 19W  
 BOOK PAGE 139 LINE 15

*Richard S. Davis*  
 Richard S. Davis

Subscribed and sworn to before me this 3rd day of November, 1953.  
 My Comm Exp. 7-8-53  
*Mary Ellen Cummins*  
 Notary Public