

STATE OF KANSAS
STATE CORPORATION COMMISSION

WELL PLUGGING RECORD

Give All Information Completely
Make Required Affidavit
Mail or Deliver Report to:
Conservation Division
State Corporation Commission
800 Biting Building
Wichita, Kansas

Edwards County. Sec 27 Twp 24 Rge 19 (E) W (W)

Location as "NE/CNW%SW%" or footage from lines NW SE NW

Lease Owner H. F. Thompson & Associates

Lease Name Copp Well No. 1

Office Address Box 33, Ellinwood, Kansas

Character of Well (completed as Oil, Gas or Dry Hole) dry hole

Date well completed April 11 19 54

Application for plugging filed 19

Application for plugging approved April 11 19 54


Plugging commenced April 11 19 54

Plugging completed April 11 19 54

Reason for abandonment of well or producing formation dry hole

If a producing well is abandoned, date of last production 19

Was permission obtained from the Conservation Division or its agents before plugging was commenced? YES

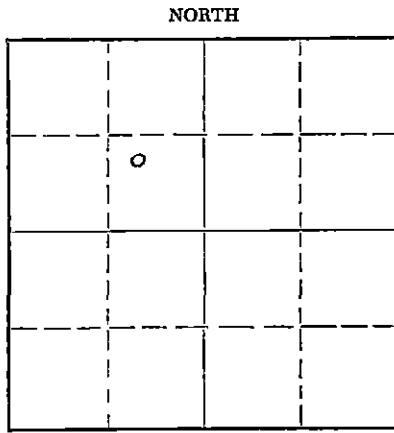

Locate well correctly on above Section Plat

Name of Conservation Agent who supervised plugging of this well M.A. Rives Box 8 Pratt, Kansas

Producing formation Depth to top Bottom Total Depth of Well 5061 Feet

Show depth and thickness of all water, oil and gas formations.

OIL, GAS OR WATER RECORDS

CASING RECORD

FORMATION	CONTENT	FROM	TO	SIZE	PUT IN	PULLED OUT
				8 5/8	280'	none

Describe in detail the manner in which the well was plugged, indicating where the mud fluid was placed and the method or methods used in introducing it into the hole. If cement or other plugs were used, state the character of same and depth placed, from feet to feet for each plug set.

Hole filled with heavy rotary mud to 280 ft. Plug set @ 280'. Filled to 40' with 1 sk hulls 20 sks cement. Top plug set at 40'. Filled to surface with 10 sks cement 1 sk hulls.

(If additional description is necessary, use BACK of this sheet)

Name of Plugging Contractor Iron Drilling Co.
Address Tulsa, Oklahoma

STATE OF Kansas, COUNTY OF Barton, ss.
H.F. THompson & Assco. by George Langfeld (employee of owner) or (owner or operator) of the above-described well, being first duly sworn on oath, says: That I have knowledge of the facts, statements, and matters herein contained and the log of the above-described well as filed and that the same are true and correct. So help me God.

(Signature) George Langfeld
P. O. Box #33, Ellinwood, Kansas.
(Address)

SUBSCRIBED AND SWORN TO before me this 4th day of June 19 54

My commission expires Sept. 10, 1955

M. Kenneth Stuen Notary Public.

PLUGGING
FILE SEC 27 T 24 R 19W
BOOK PAGE 27 LINE 8

RECEIVED
STATE CORPORATION COMMISSION
JUL 15 1954 6-5-54
CONSERVATION DIVISION
Wichita, Kansas

DRILLER'S LOG

OPERATOR: H. F. THOMPSON & ASSOCIATES
 CONTRACTOR: IRON DRILLING COMPANY
 Commenced: March 29, 1954
 Completed: April 11, 1954

COPP NO. 1
 NW SE NW Sec. 27-24S-19W
 Edwards County, Kansas
 Elev: 2163 K.B.

Casing: 8 5/8" set at 280 with 250 sacks

Well re-opened at 4560 and drilled to a total depth of 5061.

Lime	4584	
Lime and chert	4636	
Sand	4640	
Sand and lime	4666	
Sand	4668	
Chert and lime	4706	
Sand and lime	4730	
Chert and lime	4803	
Lime	4820	
Lime and chert	4855	
Lime	4910	
Lime and shale	5061	
R.T.D.	5061	D & A

STATE OF Kansas)
 COUNTY OF Barton) SS

I, the undersigned, being duly sworn on oath, state that the above statement and log are true and a correct record and log of the well drilled at the location above described.

Subscribed and sworn to before me this 4th day of June, 1954.

W. Kenneth Stearn
 Notary Public

My commission expires Sept. 10, 1954

PLUGGING
 FILE SEC 27-24-19W
 BOOK PAGE 22 LINE 8

EDWARDS COUNTY, KANSAS
 COMMISSIONER OF REVENUE
 WICHITA, KANSAS