


STATE OF KANSAS  
STATE CORPORATION COMMISSION

Give All Information Completely  
Make Required Affidavit  
Mail or Deliver Report to:  
Conservation Division  
State Corporation Commission  
211 No. Broadway  
Wichita, Kansas

WELL PLUGGING RECORD

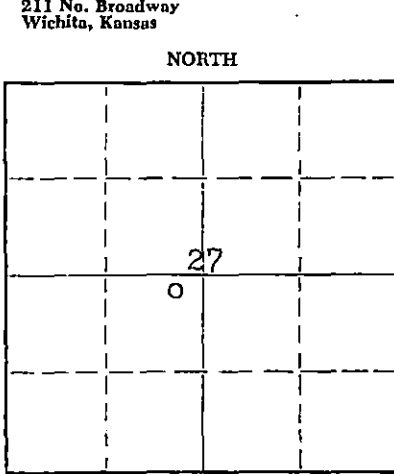

Locate well correctly on above  
Section Plat

Stafford County. Sec. 27 Twp. 24S Rge. (E)12 (W)  
Location as "NE/CNW/SW" or footage from lines C/NE NE SW  
Lease Owner Sun Oil Company  
Lease Name Budde Well No. 1  
Office Address Box 1348, Tulsa, Oklahoma  
Character of Well (completed as Oil, Gas or Dry Hole) oil  
Date well completed 9-9- 19 55  
Application for plugging filed 7-17- 19 56  
Application for plugging approved 7-17- 19 56  
Plugging commenced 7-21- 19 56  
Plugging completed 7-24- 19 56  
Reason for abandonment of well or producing formation Depleted

If a producing well is abandoned, date of last production December 1 19 55  
Was permission obtained from the Conservation Division or its agents before plugging was commenced? Yes

Name of Conservation Agent who supervised plugging of this well Mr. Brundege, Hoisington, Kansas  
Producing formation Viola Lime Depth to top 3920 Bottom 3950 Total Depth of Well 4132 Feet  
Show depth and thickness of all water, oil and gas formations.

OIL, GAS OR WATER RECORDS

CASING RECORD

FORMATION	CONTENT	FROM	TO	SIZE	PUT IN	PULLED OUT
Viola Lime	Wtr & small show oil	3918	3932	5 1/2"	4124.45'	2571.81'

Describe in detail the manner in which the well was plugged, indicating where the mud fluid was placed and the method or methods used in introducing it into the hole. If cement or other plugs were used, state the character of same and depth placed, from \_\_\_\_\_ feet to \_\_\_\_\_ feet for each plug set.

7-21-56 Plugged back 4090-3905' with sand, capped with 5 sax cement 3905-3865'  
7-22-56 Shot pipe off at 2666' and pulled 25 joints.  
7-23-56: Pulled all but 800' and circulated oil & water from hole with mud. Pulled balance of pipe and placed rock bridge 280'-270', capped with 200 sax cement 270'  
7-24-56: Checked bottom plug, O.K. Set rock bridge at 35' and cemented to surface with 10 sacks cement.

(If additional description is necessary, use BACK of this sheet)

Name of Plugging Contractor Western Supply Company  
Address Chase, Kansas

STATE OF OKLAHOMA, COUNTY OF TULSA, ss.  
J. H. Allen (employee of owner) or (owner/procurator) of the above-described well, being first duly sworn on oath, says: That I have knowledge of the facts, statements, and matters herein contained and the log of the above-described well as filed and that the same are true and correct. So help me God.

(Signature) J. H. Allen  
Box 1348, Tulsa, Oklahoma  
(Address)

SUBSCRIBED AND SWORN TO before me this 7th day of August 19 56

My commission expires May 9, 1959

Blanche Forth Notary Public.

RECEIVED  
CORPORATION COMMISSION

AUG 8 1956

8-8-56

PLUGGING  
FILE SEC 27 T. 24 R. 12W  
BOOK PAGE 81 LINE 19

CONSERVATION DIVISION  
Wichita, Kansas

WELL LOG

SUN OIL COMPANY  
 No. 1 Budge  
 NE/4 SE/4 SW/4  
 Sec. 27, Twp. 24S, Rge. 12W  
 Stafford County, Kansas

	FEET	TO
Clay	0	25
Sand	25	165
Shale & gravel	165	215
Shale	215	350
Red Beds & shale	350	500
Red Beds	500	663
Anhydrite	X 663	690
Red Bed, shale & shells	690	1015
Shale & shells	1015	1180
Salt	1180	1230
Shale & lime	1230	1530
Lime	1530	1760
Lime & shale	1760	1870
Lime	1870	2100
Lime & shale	2100	2205
Lime & shale	2205	2305
Lime, broken	2305	2435
Shale & Lime	2435	2775
Lime	2775	2830
Shale & lime	2830	3020
Lime	3020	3342
Shale (Heebner)	3342	3346
Lime (Leavenworth)	3346	3352
Shale (Snyderville)	3352	3358
Lime (Toronto)	3358	3380
Shale (Douglas)	3380	3493
Lime (Brown)	3493	3500
Limey shale	3500	3516
Lime & shale (Lansing)	3516	3765
Shale (Marmaton)	3765	3768
Lime & shale	3768	3845
Shale & cherty lime	3845	3920
Dolomite (Viola) (S&O)	3920	3950
Chert	3950	3962
Dolomite)	3962	3968
Dolomite & chert	3968	4000
Chert	4000	4012
Dolomite	4012	4030
Lime	4030	4050
Shale (Simpson)	4050	4056
Sand (let Simpson)	4056	4062
Sandy shale	4062	4074
Sand (S&O)	4074	4086
Shale	4086	4117
Dolomite (Arbuckle)	4117	4132 T.D.

Drilling Commenced: 6-5-52  
 Drilling Completed: 6-25-52  
 Date of 1st Production: 6-30-52  
 Well Completed: 7-5-52

CASING RECORD:

6-6-52: Set 8-5/8" 32# 8V casing at 350', cemented with 300 sacks cement and 3 sacks calcium chloride.

6-22-52: Set 5 1/2" OD 14# J-55 88 casing at 4129.45', cemented with 250 sacks.

CASING PERFORATIONS:

3918'-3932' w/4 shots/ft. (jet).

I hereby certify that the foregoing is a true and correct copy of the Budge No. 1 Well Log as it is recorded on the books of the Sun Oil Company.

*[Signature]*  
 Glen A. Hughes  
 Notary Public

STATE OF OKLAHOMA )  
 ) SS  
 COUNTY OF TULSA )

Subscribed and sworn to before me this 25 day of July, 1952.

My Commission Expires:  
*[Signature]* 9. 1952

PLUGGING  
 FILE SEC 27 T 24 R 12W  
 BOOK PAGE 81 LINE 19

*[Signature]*  
 Notary Public

STATE CORPORATION  
 AUG 6 1952  
 CONSERVATION DIVISION  
 Wichita, Kansas