


STATE OF KANSAS  
STATE CORPORATION COMMISSION

WELL PLUGGING RECORD

Give All Information Completely  
Make Required Affidavit  
Mail or Deliver Report to  
Conservation Division  
State Corporation Comm.  
245 North Water  
Wichita, KS 67202

Kingman County, Sec. 29 Twp 28S Rge 10W E/W  
Location as "NE/CNW 1/4 SW 1/4" or footage from lines  
NE NW NE  
Lease Owner Mull Drilling Company, Inc.  
Lease Name Johnson 'B' # 1 Well No. 1  
Office Address 221 North Main Suite 300; Wichita, KS 67202  
Character of Well (Completed as Oil, Gas or Dry Hole)

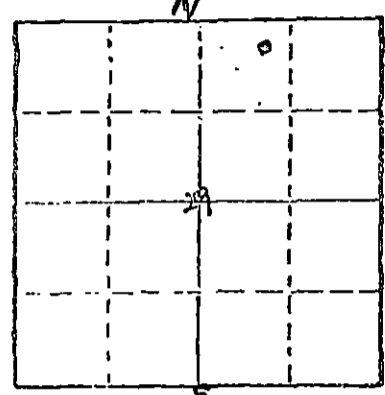

DRY HOLE  
Date Well completed March 28, 1981  
Application for plugging filed March 28, 1981  
Application for plugging approved March 28, 1981  
Plugging commenced March 28, 1981  
Plugging completed March 28, 1981  
Reason for abandonment of well or producing formation

Dry Hole  
If a producing well is abandoned, date of last production 19

Was permission obtained from the Conservation Division or its agents before plugging was commenced? Yes

Name of Conservation Agent who supervised plugging of this well M. V. Leslie  
Producing formation Depth to top Bottom Total Depth of Well  
Show depth and thickness of all water, oil and gas formations.

OIL, GAS OR WATER RECORDS

CASING RECORD

FORMATION	CONTENT	FROM	TO	SIZE	PUT IN	PULLED OUT
Surface Casing		0	322	8 5/8		0

Describe in detail the manner in which the well was plugged, indicating where the mud fluid was placed and the method or methods used in introducing it into the hold. If cement or other plugs were used, state the character of same and depth placed, from feet to feet for each plug set.

- 40 Sacks @ 310' 40 - 60 Poz Mix
- 10 Sacks @ 40' " " "
- 10 Sacks in Rat Hole
- 5 Sacks in Mouse Hole
- 5 sacks in Water well Plugged down at 9:15 P.M. 3-28-81  
Halliburton Cement

(If additional description is necessary, use BACK of this sheet)

Name of Plugging Contractor Blue Goose Drilling Company, Inc.

STATE OF KANSAS COUNTY OF BARTON, ss.  
George E. Miller, Jr. (owner or operator)  
of the above-described well, being first duly sworn on oath, says: That I have knowledge of the facts, statements, and matters herein contained and the log of the above-described well as filed and that the same are true and correct. So help me God.

(Signature) George E. Miller, Jr.  
P.O. Box 1413; Great Bend, KS 67530  
(Address)

SUBSCRIBED AND SWORN TO before me this 31st day of March, 1981

Helen C. Standley  
Notary Public.  
APR - 3 1981

My commission expires 12-8-83

HELEN C. STANDLEY  
Barton County, Kansas  
My Appt. Exp. \_\_\_\_\_

CONSERVATION DIVISION  
Wichita, Kansas

4-3-81

WELL LOG

JOHNSON 'B' # 1  
NE NW NE Sec 29-28S-10W  
Kingman County, Kansas

NAME OF OPERATOR: Mull Drilling Company, Inc.  
221 North Main Suite  
Wichita, KS 67530

COMPLETION DATE: March 28, 1981

<u>FROM</u>	<u>TO</u>	
0	170	Sand
170	322	Shale
322	940	Sand
940	1527	Shale
1527	1570	Lime and Shale
1570	1965	Shale
1965	2275	Shale and Lime
2275	2558	Shale with Lime streaks
2558	4205	Shale and Lime
4205	5215	Mississippian
4205	4270	Shale and Lime
4270		T.D.


STATE OF KANSAS

COUNTY OF BARTON ss

George E. Miller, Jr., President of Blue Goose Drilling Co., Inc. being first duly sworn on oath says: That I have knowledge of the facts, statements and matters herein contained and the log of the above described well as filed and that the same are true and correct.

*George E. Miller, Jr.*  
George E. Miller, Jr.

Subscribed and sworn before me this 1st Day of April 1981.

	HELEN C. STANDLEY
	Barton County, Kansas My Appt. Exp. 12-8-83

*Helen C. Standley*  
Notary Public

My Commission Expires: 12-8-83

RECEIVED  
STATE CORPORATION COMMISSION

APR - 3 1981

CONSERVATION DIVISION  
Wichita, Kansas