

15-095-211000000


STATE OF KANSAS
STATE CORPORATION COMMISSION

WELL PLUGGING RECORD

Give All Information Completely
Make Required Affidavit
Mail or Deliver Report to
Conservation Division
State Corporation Comm.
245 North Water
Wichita, KS 67202

Kingman County, Sec. 23 Twp. 28S Rge. 9W E/W
Location as "NE/CNW 1/4 SW 1/4" or footage from lines

C NW NE
Lease Owner MCAAM Oil Company, Inc.
Lease Name Goff Well No. 1
Office Address 250 N. Rock Rd., Suite 150, Wichita, KS 67206
Character of Well (Completed as Oil, Gas or Dry Hole)

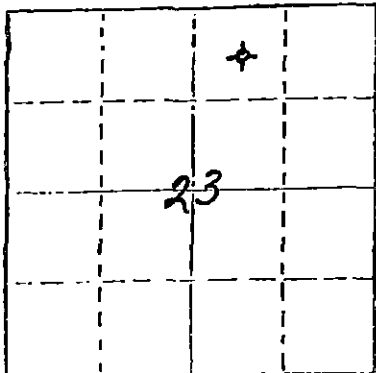

Locate well correctly on above
Section Plat

Dry Hole
Date Well completed August 27, 1981
Application for plugging filed August 27, 1981
Application for plugging approved August 27, 1981
Plugging commenced August 27, 1981
Plugging completed August 27, 1981
Reason for abandonment of well or producing formation

Dry Hole
If a producing well is abandoned, date of last production 19

Was permission obtained from the Conservation Division or
its agents before plugging was commenced? Yes

Name of Conservation Agent who supervised plugging of this well Wm. T. Owen
Producing formation Depth to top Bottom Total Depth of Well 4505
Show depth and thickness of all water, oil and gas formations.

OIL, GAS OR WATER RECORDS

CASING RECORD

FORMATION	CONTENT	FROM	TO	SIZE	PUT IN	PULLED OUT
		0'	213'	8-5/8"	206.28'	None

Describe in detail the manner in which the well was plugged, indicating where the mud fluid
was placed and the method or methods used in introducing it into the hold. If cement or other
plugs were used, state the character of same and depth placed, from feet to
feet for each plug set.

Plugged with 50 sacks cement at 620';
40 sacks cement at 200'; 10 sacks cement
at 40'; and 10 sacks cement in rat hole.

(If additional description is necessary, use BACK of this sheet)


Name of Plugging Contractor Allied Cementing Co.

STATE OF KANSAS COUNTY OF SEDGWICK, ss.
John D. Knightley Agent (employee of owner) or (owner or operator)
of the above-described well, being first duly sworn on oath, says: That I have knowledge of
the facts, statements, and matters herein contained and the log of the above-described well
as filed and that the same are true and correct. So help me God.

(Signature) *John D. Knightley*
221 S. Broadway, Suite 400, Wichita, KS 67202
(Address)

NOTARIZED AND SWORN TO before me this 1st day of September, 1981

My commission expires March 12, 1983

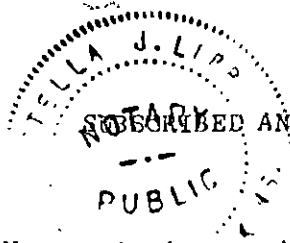

Stella J. Lipa
Notary Public.

RECEIVED
STATE CORPORATION COMMISSION

SEP - 2 1981
CONSERVATION DIVISION
Wichita, Kansas

15-095-211000000

MCAAM Oil Company, Inc.
250 N. Rock Road, Suite 150
Wichita, Kansas 67206

Goff #1
C NW NE Sec. 23-28S-9W
Kingman County, Kansas

Contractor: D. R. Lauck Oil Company, Inc.
221 S. Broadway, Suite 400
Wichita, Kansas 67202

Commenced: August 19, 1981
Completed: August 27, 1981

Drillers Log

Sand	85
Red Bed	850
Shale & Shells	2870
Shale & Lime	3725
Lime & Shale	4414
Lime	4505 RTD