

WELL PLUGGING RECORD

15-095-00378-0000

Give All Information Completely
Make Required Affidavit
Mail or in person Report to:
Conservation Division
State Corporation Commission
800 Bitting Building
Wichita, Kansas

Kingman County. Sec. 30 Twp. 28S Rge. 9 (E) W (W)

Location as "NE/CNW*SW*" or footage from lines. SW SW NW

Lease Owner S. A. Berwick & Aurora Gasoline Company

Lease Name Murphy Well No. 1

Office Address P. O. Box 64, Great Bend, Kansas

Character of Well (completed as Oil, Gas or Dry Hole) Dry Hole

Date well completed 9-28-54 19

Application for plugging filed Yes 19

Application for plugging approved Yes 19


Plugging commenced 9-28-54 19

Plugging completed 9-28-54 19

Reason for abandonment of well or producing formation

If a producing well is abandoned, date of last production 19

Was permission obtained from the Conservation Division or its agents before plugging was commenced? Yes

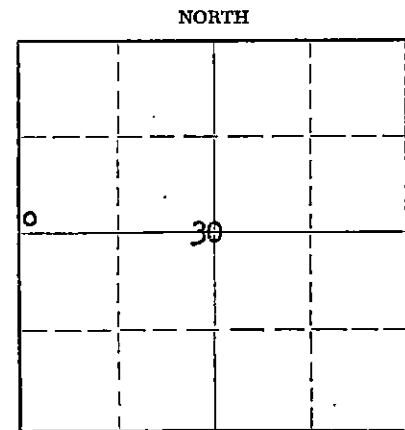

Locate well correctly on above Section Plat

Name of Conservation Agent who supervised plugging of this well Merle Rives

Producing formation - Depth to top - Bottom - Total Depth of Well 4669' Feet

Show depth and thickness of all water, oil and gas formations.

OIL, GAS OR WATER RECORDS

CASING RECORD

FORMATION	CONTENT	FROM	TO	SIZE	PUT IN	PULLED OUT

Describe in detail the manner in which the well was plugged, indicating where the mud fluid was placed and the method or methods used in introducing it into the hole. If cement or other plugs were used, state the character of same and depth placed, from _____ feet to _____ feet for each plug set.

Filled Hole With Heavy Mud to 200 feet, Bridged hole 200 ft. cemented with 20 sacks, filled hole to 35 ft., bridged hole 35 ft., cemented with 10 sacks

RECORDED
10-04-54

(If additional description is necessary, use BACK of this sheet)

Name of Plugging Contractor _____

Address _____

STATE OF KANSAS, COUNTY OF BARTON, ss.

S. A. Berwick (employee of owner) or (owner or operator) of the above-described well, being first duly sworn on oath, says: That I have knowledge of the facts, statements, and matters herein contained and the log of the above-described well as filed and that the same are true and correct. So help me God.

(Signature) S. A. Berwick

Box 64, Great Bend, Kansas (Address)

SUBSCRIBED AND SWORN TO before me this 30th day of September 19 54

John W. [Signature]

Notary Public.

My commission expires April 11, 1955

PLUGGING
FILED SEC. 20 28-54
BOOK PAGE 67 LINE 31

15-095-00378-0000

S. A. BERWICK DRILLING COMPANY
and
AURORA GASOLINE COMPANY
1105 Williams
Great Bend, Kansas

Murphy No. 1

Total Depth: 4669'
Commenced R. D. : 9-11-54
Completed R. D. : 9-28-54

SW SW NW Sec. 30-28-9
Kingman County, Kansas
Elevation: 1723' D.F.
Initial Prod.: Dry
Contractor: S. A. Berwick
Drilling Co.

Strata	Depth
Sand	0- 120
Red rock and Shale	120- 200
Shale and Sand	200- 325
Red Bed	325- 450
Shale and Shells	450- 765
Anhydrite	765- 810
Shale and Shells	810-1245
Lime	1245-1265
Shale and Shells	1265-1770
Lime and Shale	1770-2240
Shale and Shells	2240-2415
Lime and Shale	2415-2600
Shale	2600-2740
Lime and Shale	2740-3240
Lime	3240-3820
Lime (Cherty)	3820-3845
Lime	3845-4174
Chat and Lime	4174-4220
Lime	4220-4250
Lime and Shale	4250-4455
Lime and Viola	4455-4475
Lime	4475-4500
Lime and Shale	4500-4535
Lime	4535-4669

I hereby certify the above a true and correct log of said well as reflected by the daily drilling report.

S. A. BERWICK DRILLING COMPANY

By S. A. Berwick
S. A. Berwick Owner

Signed and sworn to in my presence this 29 day of September, 1954, by S. A. Berwick, owner of the S. A. Berwick Drilling Company.

John W. Ross
Notary Public

My Commission Expires: April 11, 1955

RECEIVED
CORPORATION COMMISSION
OCT - 4 1954
CORPORATION DIVISION
Kansas

PLUGGING
WELL SEC 30-28-9W
BOOK PAGE 67 LINE 34