


15-095-01536-0000

Give All Information Completely  
Make Required Affidavit  
Mail or Deliver Report to:  
Conservation Division  
State Corporation Commission  
500 Bitting Building  
Wichita, Kansas

OR  
FORMATION PLUGGING RECORD

Strike out upper line  
when reporting plug-  
ging off formations.

NORTH

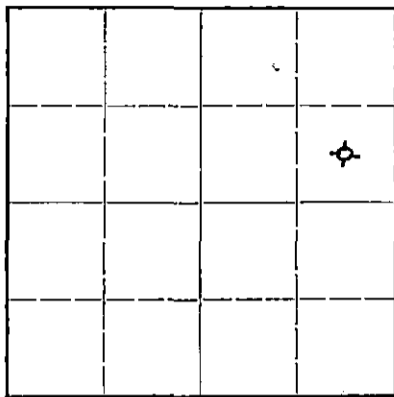

Locate well correctly on above  
Section Plat

Kingman County. Sec 30 Twp 28 Rge 9 (W)  
Location as "NE 1/4 NW 1/4 SW 1/4" or footage from lines SE/4-NE/4-NE/4  
Lease Owner Plains Exploration Company  
Lease Name Allen Well No. 1  
Office Address 524 University Building Denver 2, Colorado  
Character of Well (completed as Oil, Gas or Dry Hole) Dry Hole  
Date well completed May 5 1949  
Application for plugging filed May 5 1949  
Application for plugging approved May 5 1949  
Plugging commenced May 5 1949  
Plugging completed May 6 1949  
Reason for abandonment of well or producing formation Dry Hole

If a producing well is abandoned, date of last production 19  
Was permission obtained from the Conservation Division or its agents before plugging was com-  
menced? Yes

Name of Conservation Agent who supervised plugging of this well C. D. Stough  
Producing formation Depth to top Bottom Total Depth of Well 4413' Feet  
Show depth and thickness of all water, oil and gas formations.

OIL, GAS OR WATER RECORDS

CASING RECORD

| Formation | Content | From  | To    | Size   | Put In | Pulled Out |
|-----------|---------|-------|-------|--------|--------|------------|
| Viola     | Water   | 4412' | 4413' | 8 5/8" | 220'   | none       |

Describe in detail the manner in which the well was plugged, indicating where the mud fluid was placed and the method or methods used in introducing it into the hold. If cement or other plugs were used, state the character of same and depth placed, from feet to feet for each plug set.

Hole filled with heavy mud from 4413' to 220'

Wood plug drove down with drill pipe to 220'

20 sks. of cement mixed and poured thru drill pipe

Filled to 30' below bottom of cellar with heavy mud.

Wood plug drove to 30' below bottom of cellar with drill pipe hole then filled to bottom of cellar with cement.

RECEIVED

MAY 16 1949 OS-116-49  
STATE CORPORATION  
COMMISSION  
KANSAS

(If additional description is necessary, use BACK of this sheet)

Correspondence regarding this well should be addressed to Plains Exploration Company  
Address 524 University Building  
Denver 2, Colorado

STATE OF Kansas, COUNTY OF Stafford, ss.  
E. E. Duncan (employee of owner) or (owner or operator) of the above-described well,

being first duly sworn on oath, says: That I have knowledge of the facts, statements, and matters herein contained and the log of the above-described well as filed and that the same are true and correct. So help me God.

(Signature) E. E. Duncan

Stafford, Kansas (Address)

SUBSCRIBED AND SWORN to before me this 7 th day of May 1949

My commission expires Aug 4 - 1950

Notary Public.

PLUGGING  
FILE SEC 30 T 28 R 9w  
BOOK PAGE 95 LINE 38

15-095-01536-0000

PLAINS EXPLORATION COMPANY  
DRILLERS WELL LOG  
ALLEN #1

Company--Plains Exploration Company  
Farm--Allen #1

Location  
SE/4-NE/4-NE/4  
Sec. 30 T. 28S R. 9W

Contractor--Sterling Drlg. Co.  
Comm.--April 15, 1949  
Comp.--May 5, 1949  
Shot or Treated--None  
Total Depth--4413' K. B.

County--Kingman  
Elevation--1710' K. B.  
Production--Dry Hole

Casing Record

8 5/8" set at 220' with 200 sks. cement circulated.

All measurments carried from Kelly Bushing.

6' Kelly Bushing  
100' Sand  
160' Clay  
215' Shale & Shells  
410' Red Bed & Shells  
760' Shale & Shells  
770' Anhydrite  
1420' Shale & Shells  
2020' Shale & Lime  
2090' Lime  
2435' Shale & Lime  
2765' Shale  
3045' Shale & Lime  
3195' Lime  
3455' Lime & Shale  
3505' Lime  
3575' Shale & Lime  
3975' Lime  
4135' Shale & Lime  
4140' Chert  
4185' Chert & Lime  
4412' Shale  
4413' Cherty Lime

Geologists Tops

L. K. C.  
Brown Lime 3561'  
White Lime 3588'  
Miss. 4129'  
Viola 4412'

Drill Stem Test

Tool open 30 min. from 4128' to 4135'  
Recovered 90' of oil & gas  
Cut mud with some free oil.

Tool open 1 hr. from 4130' to 4140'  
Recovered 165' of oil & gas  
cut mud and clear water some free  
oil but much more clear salty water.

Tool open 1 hr. from 4383' to 4413'  
One ft. of Viola showing fair porosity  
Recovered 150' of mud & water no  
oil or gas. Well abandoned.

MAY 16 1949

STATE COMMISSION  
COMMISSION  
KANSAS

I HEREBY CERTIFY THE ABOVE RECORD IS A TRUE AND CORRECT RECORD OF THE  
DRILLERS LOG ON THIS WELL.

SIGNED

E. B. Duncan

SUBSCRIBED AND SWORN TO BEFORE ME THIS 11th DAY OF May 1949

MY COMMISSION EXPIRES Aug 4-1950

[Signature]  
NOTARY PUBLIC

