


15-095-20924-0000

STATE OF KANSAS
STATE CORPORATION COMMISSION

WELL PLUGGING RECORD

Give All Information Completely
Make Required Affidavit
Mail or Deliver Report to
Conservation Division
State Corporation Comm.
245 North Water
Wichita, KS 67202

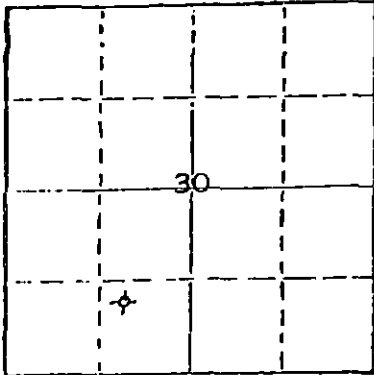

Locate well correctly on above
Section Plat

Kingman County. Sec. 30 Twp. 28S Rge. 9W E/W
Location as "NE/CNW $\frac{1}{4}$ SW $\frac{1}{4}$ " or footage from lines

NW SE SW
Lease Owner John Jay Darrah, Jr.
Lease Name Hennings Well No. 1
Office Address 1010 Century Plaza Bldg., Wichita, Ks.
Character of Well (Completed as Oil, Gas or Dry Hole)

Dry Hole

Date Well completed February 17, 1980
Application for plugging filed February 17, 1980
Application for plugging approved February 17, 1980
Plugging commenced February 17, 1980
Plugging completed February 17, 1980
Reason for abandonment of well or producing formation

Dry Hole.

If a producing well is abandoned, date of last production 19

Was permission obtained from the Conservation Division or its agents before plugging was commenced? Yes

Name of Conservation Agent who supervised plugging of this well Wm. T. Owen
Producing formation Depth to top Bottom Total Depth of Well 4435'
Show depth and thickness of all water, oil and gas formations.

OIL, GAS OR WATER RECORDS

CASING RECORD

FORMATION	CONTENT	FROM	TO	SIZE	PUT IN	PULLED OUT
		0'	268'	8-5/8"	261.69'	None

Describe in detail the manner in which the well was plugged, indicating where the mud fluid was placed and the method or methods used in introducing it into the hold. If cement or other plugs were used, state the character of same and depth placed, from feet to feet for each plug set.

Plugged with 40 sacks cement at 270',
solid bridge plug and 10 sacks cement
at 40', and 5 sacks cement in rat hole.

(If additional description is necessary, use BACK of this sheet)

Name of Plugging Contractor Allied Cementing Co.



STATE OF KANSAS COUNTY OF SEDGWICK, ss.
John D. Knightley Agent (employee of owner) or (owner or operator)
of the above-described well, being first duly sworn on oath, says: That I have knowledge of the facts, statements, and matters herein contained and the log of the above-described well as filed and that the same are true and correct. So help me God.

(Signature) [Signature]
221 S. Broadway, Wichita, Kansas
(Address)

DESCRIBED AND SWORN TO before me this 12th day of March, 1980

[Signature]
Notary Public.

My commission expires March 12, 1983

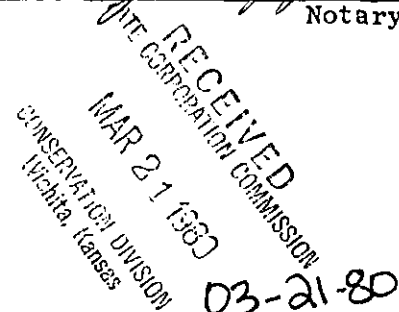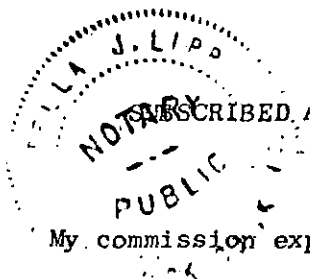

15095-20924-0000

John Jay Darrah, Jr.
1010 Century Plaza Bldg.
Wichita, Kansas 67202

- Hennings #1, -
NW SE SW Sec. 30-28S-9W
Kingman County, Kansas

Contractor: D. R. Lauck Oil Company, Inc.
221 S. Broadway, Suite 400
Wichita, Kansas 67202

Commenced: February 6, 1980
Completed: February 17, 1980

Drillers Log

Shale & Sand	271
Red Bed	350
Red Bed & Shale	1280
Shale & Shells	1560
Shale & Lime	1820
Shale & Shells	1920
Shale & Lime	2660
Lime & Shale	2885
Shale & Lime	3185
Lime & Shale	3390
Lime	4435 RTD

RECEIVED
REGISTRATION COMMISSION
MAR 21 1980
CONSERVATION DIVISION
Wichita, Kansas