


STATE OF KANSAS  
STATE CORPORATION COMMISSION

15-095-21050-0000

## WELL PLUGGING RECORD

Give All Information Completely  
Make Required Affidavit  
Mail or Deliver Report to  
Conservation Division  
State Corporation Comm.  
245 North Water  
Wichita, KS 67202

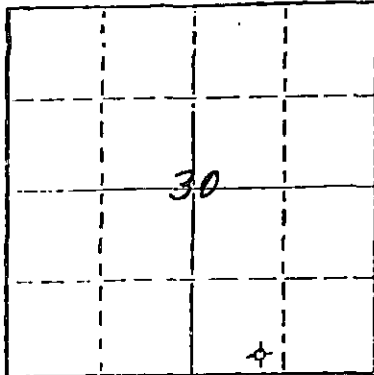

Locate well correctly on above  
Section Plot

Kingman County, Sec. 30 Twp. 28S Rge. 9W E/W  
Location as "NE/CNW $\frac{1}{4}$ SW $\frac{1}{4}$ " or footage from lines

SE SW SE  
Lease Owner John Jay Darrah, Jr.  
Lease Name Conrad Well No. 3  
Office Address 405 Century Plaza Bldg., Wichita, KS 67202  
Character of Well (Completed as Oil, Gas or Dry Hole)

Dry Hole  
Date Well completed February 27, 1981  
Application for plugging filed February 27, 1981  
Application for plugging approved February 27, 1981  
Plugging commenced February 27, 1981  
Plugging completed February 27, 1981  
Reason for abandonment of well or producing formation

Dry Hole  
If a producing well is abandoned, date of last production 19

Was permission obtained from the Conservation Division or its agents before plugging was commenced? Yes

Name of Conservation Agent who supervised plugging of this well Wm. T. Owen  
Producing formation Depth to top Bottom Total Depth of Well 4449'  
Show depth and thickness of all water, oil and gas formations.

## OIL, GAS OR WATER RECORDS

## CASING RECORD

FORMATION	CONTENT	FROM	TO	SIZE	PUT IN	PULLED OUT
		0'	255'	8-5/8"	249.85'	None

Describe in detail the manner in which the well was plugged, indicating where the mud fluid was placed and the method or methods used in introducing it into the hold. If cement or other plugs were used, state the character of same and depth placed, from feet to feet for each plug set.

Plugged with 40 sacks cement at 255';  
10 sacks cement at 40'; and 10 sacks  
cement in rat hole.

(If additional description is necessary, use BACK of this sheet)

Name of Plugging Contractor Allied Cementing Co.

STATE OF KANSAS COUNTY OF SEDGWICK, ss.  
John D. Knightley Agent (employee of owner) or (owner or operator)  
of the above-described well, being first duly sworn on oath, says: That I have knowledge of the facts, statements, and matters herein contained and the log of the above-described well as filed and that the same are true and correct. So help me God.

(Signature)

221 S. Broadway, Wichita, Kansas 67202  
(Address)

SUBSCRIBED AND SWORN TO before me this 3rd day of March, 19 81

My commission expires March 12, 1983

Notary Public.



MAK - 5 1981  
03-05-81  
CONSERVATION DIVISION  
WICHITA, KANSAS

15095-210500000

John Jay Darrah, Jr. -  
405 Century Plaza Bldg.  
Wichita, Kansas 67202

Conrad #3  
SE SW SE Section 30-28S-9W  
Kingman County, Kansas

Contractor: D. R. Lauck Oil Company, Inc.  
221 S. Broadway, Suite 400  
Wichita, Kansas 67202

Commenced: February 20, 1981  
Completed: February 27, 1981

Drillers Log

Clay, Sand & Red Bed	130
Clay & Red Bed	260
Red Bed & Lime	625
Shale & Shells	1625
Shale	2865
Shale & Lime	4235
Lime	4449 RTD