


Give All Information Completely  
Make Required Affidavit  
Mail or Deliver Report to:  
Conservation Division  
State Corporation Commission  
800 Bittling Building  
Wichita, Kansas

WELL PLUGGING RECORD

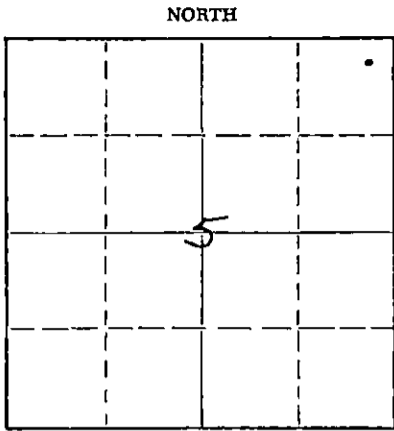

Locate well correctly on above Section Plat

Kingman County. Sec. 5 Twp. 28S Rge. ~~NE~~ 9 (W)  
Location as "NE/CNW/SW" or footage from lines Ne/4 NE/4 NE/4  
Lease Owner: Midwest Oil Corporation  
Lease Name: Eleanor Sears Well No. 1  
Office Address: 606 Sinclair Bldg., Fort Worth, Texas  
Character of Well (completed as Oil, Gas or Dry Hole) Dry Hole  
Date well completed January 7, 19 55  
Application for plugging filed January 7, 19 55  
Application for plugging approved January 7, 19 55  
Plugging commenced January 7, 19 55  
Plugging completed January 8, 19 55  
Reason for abandonment of well or producing formation Dry Hole

If a producing well is abandoned, date of last production 19  
Was permission obtained from the Conservation Division or its agents before plugging was commenced? Yes

Name of Conservation Agent who supervised plugging of this well Ruel Durkee  
Producing formation None Depth to top Bottom Total Depth of Well 4540 Feet  
Show depth and thickness of all water, oil and gas formations.

OIL, GAS OR WATER RECORDS

CASING RECORD

FORMATION	CONTENT	FROM	TO	SIZE	PUT IN	PULLED OUT
				8-5/8	248	0

Describe in detail the manner in which the well was plugged, indicating where the mud fluid was placed and the method or methods used in introducing it into the hole. If cement or other plugs were used, state the character of same and depth placed, from feet to feet for each plug set.

4540 - 250 Heavy mud  
250 - 195 15 sacks cement and 1/2 sack hulls  
195 - 25 Heavy mud  
25 - 0 5 sacks cement and 1/2 sack hulls

(If additional description is necessary, use BACK of this sheet)  
Name of Plugging Contractor Drilling and plugging by Iron Drilling Company  
Address 1206 Philtower Building, Tulsa, Oklahoma

STATE OF Texas, COUNTY OF Tarrant, ss.  
K. L. Dominy (employee of owner) or (owner or operator) of the above-described well, being first duly sworn on oath, says: That I have knowledge of the facts, statements, and matters herein contained and the log of the above-described well as filed and that the same are true and correct. So help me God.

(Signature) *K L Dominy*  
(Address)

SUBSCRIBED AND SWORN to before me this 12th day of January, 19 55

My commission expires

*Patricia Trippet*  
PATRICIA TRIPPET, Notary Public  
In and for Tarrant County, Texas  
My commission expires June 1, 1955

**PLUGGING**  
FILE SEC 5 T 28 R 9W  
BOOK PAGE 89 LINE 39

01-13-55  
DIVISION  
OF OIL AND GAS

ELANOR SEARS NO. 1  
DRILLER'S LOG

Well Location: NE NE NE Sec. 5, T-9W,  
R-28S, Kingman County,  
Kansas

0	40	Sand and surface soil
40	70	Sand
70	256	Red rock and shale
256	400	Red bed
400	520	Blue shale
520	800	Shale and shells
800	1100	Salt
1100	1322	Shale and shells
1322	1340	Anhydrite
1340	2040	Lime and shale
2040	2080	Shale and shells
2080	2115	Lime and shale
2115	2205	Broken lime and shale
2205	2285	Lime and shale
2285	2370	Shale and shells
2370	2505	Shale and lime
2505	2790	Shale and shells
2790	2885	Shale and lime
2885	3000	Shale and shells
3000	3510	Lime and shale
3510	3549	Lime
3549	3615	Lime and shale
3615	4107	Lime
4107	4125	Lime and chert
4125	4143	Lime
4143	4200	Shale and lime
4200	4290	Shale
4290	4485	Shale and lime
4485	4540 TD	Lime

RECORDED  
SERIALIZED  
JAN 28 1955  
COUNTY CLERK  
TARRANT COUNTY

STATE OF TEXAS        0  
                                  0   SS  
COUNTY OF TARRANT   0

I hereby affirm that the above and foregoing is a true and correct copy of the Driller's Log of the Elanor Sears No. 1, NE NE NE Sec. 5, T-9W, R-28S, Kingman County, Kansas.

**PLUGGING**  
NE SEC 5 T 28 R 9W  
ROCK PAGE 19 LIME 39

ORIGINAL  
SIGNED BY  
K. L. DOMINY  
\_\_\_\_\_  
District Engineer  
Midwest Oil Corporation

Subscribed and sworn to before me the undersigned Notary Public this 19th day of January, 1955.

PATRICIA TRIPPET, Notary Public  
In and for Tarrant County, Texas  
My commission expires June 1, 1955

*Patricia Trippet*