

# WELL PLUGGING RECORD

STATE OF KANSAS  
STATE CORPORATION COMMISSION

Give  on Completely  
Make Required Affidavit  
Mail or Deliver Report to:  
Conservation Division  
State Corporation Commission  
800 Bittling Building  
Wichita, Kansas

## FORMATION PLUGGING RECORD

Strike out upper line  
when reporting plug-  
ging off formations.

Reno County. Sec. 3 Twp. 24 Rge. 4 (E) (W)

Location as "NE $\frac{1}{4}$ NW $\frac{1}{4}$ SW $\frac{1}{4}$ " or footage from lines. C-NW-NE

Lease Owner. Cities Service Oil Co.

Lease Name. Baughman 'F' Well No. 4

Office Address. Bartlesville, Oklahoma

Character of Well (completed as Oil, Gas or Dry Hole) Oil Well

Date well completed August 1935


Application for plugging filed November 14 1949

Application for plugging approved November 15 1949

Plugging commenced November 27 1949

Plugging completed December 4 1949

Reason for abandonment of well or producing formation  
Non-commercial

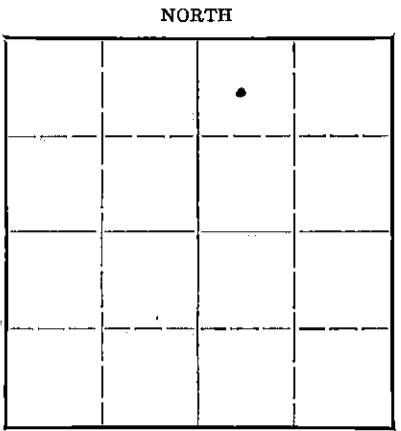

Locate well correctly on above Section Flat

If a producing well is abandoned, date of last production November 1949

Was permission obtained from the Conservation Division or its agents before plugging was commenced? Yes

Name of Conservation Agent who supervised plugging of this well Ruel Durkee

Producing formation Mississippi Depth to top 3310' Bottom 3330' Total Depth of Well 3330' Feet

Show depth and thickness of all water, oil and gas formations.

OIL, GAS OR WATER RECORDS CASING RECORD

Formation	Content	From	To	Size	Put In	Pulled Out
				15 1/2"	177'	None
				10 3/4"	522'	100
				7"	3594'	2560'

Describe in detail the manner in which the well was plugged, indicating where the mud fluid was placed and the method or methods used in introducing it into the hold. If cement or other plugs were used, state the character of same and depth placed, from \_\_\_\_\_ feet to \_\_\_\_\_ feet for each plug set.

3330' to 300' - Heavy mud

300' to 290' - Rock bridge

290' to 250' - 20 Sacks cement

250' to 18' - Heavy mud

18' to Base of cellar - 10 sacks cement

Base of cellar to surface - soil

DEC 20 1949 12-20-49  
STATE CORPORATION COMMISSION KANSAS

(If additional description is necessary, use BACK of this sheet)

Correspondence regarding this well should be addressed to R. C. Cooper  
Address Cities Service Oil Co. Box 751 Great Bend, Kansas

STATE OF Kansas, COUNTY OF Barton, ss.  
G. R. Smith (employee of owner) or (owner or operator) of the above-described well,  
being first duly sworn on oath, says: That I have knowledge of the facts, statements, and matters herein contained and the log of the above-described well as filed and that the same are true and correct. So help me God.

(Signature) G. R. Smith  
Box 505, Chase, Kansas (Address)

SUBSCRIBED AND SWORN to before me this 19th day of December, 1949  
W. G. Smith Notary Public.

My commission expires 3-17-1951  
22-287 7-47-10M

PLUGGING  
FILE SEC 3 T 24 R 42  
BOOK PAGE 124 LINE 27

WELL RECORD.

15-155-02876-0000

Company Cities Service Oil Co. Well No. 4 Farm Baughman "F"  
 Location SW NW NE Sec. 3 T. 24 R. 4W  
 Elevation 1470 County Reno State Kansas  
 Drlg. Comm. June 27, 1935 Contractor Dickey Oil Company  
 Drlg. Comp. July 27, 1935 Acid None  
 T. D. 3603 1/2 Initial Prod. 2 1/2 oil, no water, 24 hrs.

CASING RECORD:

16" OD @ 177' cem. 175 sx cement  
 10-3/4" @ 522' cem. 175 sx cement  
 7" @ 3594' cem. 175 sx cement

FORMATION RECORD:

sand 140  
 sand & shale 178  
 shale & shells 512  
 lime 710  
 shale & shells 800  
 lime 846  
 shale & shells 875  
 broken lime 905  
 shale & shells 990  
 lime 1030  
 red bed 1045  
 lime 1062  
 broken lime 1135  
 shale 1147  
 broken lime 1170  
 shale & shells 1210  
 red bed 1230  
 shale 1250  
 shale & shells 1740  
 broken lime 1780  
 shale & shells 2040  
 lime 2082  
 shells & shale 2155  
 broken lime 2175  
 lime 2273  
 broken lime & shale 2366  
 lime hard 2390  
 lime 2400  
 shale 2470  
 lime shells & shale 2556  
 broken lime 2620  
 lime 2640  
 broken lime 2650  
 lime hard 2665  
 lime broken

shale 2714  
 K. C. lime 2780  
 K. C. lime hard 2810  
 lime 2842  
 sand 2852  
 lime 2860  
 lime hard 2885  
 lime 2890  
 shale sticky 2905  
 shale & lime shells 2951  
 shale 2965  
 lime 2992  
 shale 3012  
 lime 3030  
 shale & lime shells 3106  
 shale 3115  
 lime 3150  
 shale colored 3203  
 variegated shale 3254  
 chat 3412  
 chat & lime 3426  
 chat 3447  
 lime 3453  
 chat 3465  
 lime brown 3513  
 shale & shells 3535  
 shale 3565  
 shale sticky 3586  
 shale 3594  
 lime 3602  
 sand 3603 1/2 T. D.

Top Mississippi 3254'  
 Top Hunton 3594'  
 Penetration 9 1/2'  
 Total Depth 3603 1/2'

Oil 3597-3602.

PLACING  
 FILE 22690 37 20 11 (6)  
 BOOK PAGE 124 LIN 27

NOV 15 1935  
 3727  
 11-15-35