


WELL PLUGGING RECORD

FORMATION PLUGGING RECORD

Strike out upper line when reporting plugging of formations.

STATE OF KANSAS
 STATE CORPORATION COMMISSION
 Give All Information Completely
 Make Required Affidavit
 Mail or Deliver Report to:
 Conservation Division
 State Corporation Commission
 800 Bittling Building
 Wichita, Kansas

Reno County, Sec. 3 Twp. 24 Rge. 4 ~~14~~ (W)
 Location as "NE $\frac{1}{4}$ NW $\frac{1}{4}$ SW $\frac{1}{4}$ " or footage from lines NW - SW - NE
 Lease Owner Cities Service Oil Company
 Lease Name Baughman 'F' Well No. 5
 Office Address Bartlesville, Oklahoma
 Character of Well (completed as Oil, Gas or Dry Hole) Oil Well
 Date well completed March 1936
 Application for plugging filed July 7 1949
 Application for plugging approved July 8 1949
 Plugging commenced July 15 1949
 Plugging completed July 29 1949
 Reason for abandonment of well or producing formation Non-commercial

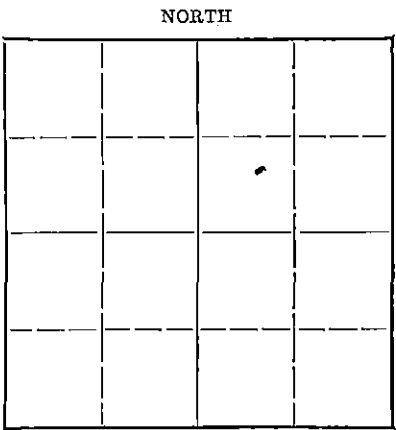

Locate well correctly on above Section Plat

If a producing well is abandoned, date of last production Not known 19
 Was permission obtained from the Conservation Division or its agents before plugging was commenced? Yes

Name of Conservation Agent who supervised plugging of this well Ruel Durkee
 Producing formation Mississippi Depth to top 3255' Bottom 3370' Total Depth of Well 3370' Feet
 Show depth and thickness of all water, oil and gas formations.

OIL, GAS OR WATER RECORDS CASING RECORD

Formation	Content	From	To	Size	Put In	Pulled Out
				16"	169'	None
				10-3/4"	502'	None
				7"	3313'	2134'
	585' - Shallow Salt Water Disposal			8-5/8"	415'	None

Describe in detail the manner in which the well was plugged, indicating where the mud fluid was placed and the method or methods used in introducing it into the hold. If cement or other plugs were used, state the character of same and depth placed, from feet to feet for each plug set.


Shallow Salt Water Disposal Well @ #5

- 585' - 350' Rock
- 350' - 300' 15 sx cement
- 300' - 6' Mud
- 6' - Top Cement Cap

Oil Well

- 3370' - 3310' - Rock
- 3310' - 3280' - 6' sx. cement
- 3280' - 360' - Mud
- 360' - 350' - Rock Bridge
- 350' - 312' - 20sx cement
- 312' - 6' - Mud
- 6' - Top - Cement Cap

8-4-49

 

(If additional description is necessary, use BACK of this sheet)

AUG 4 - 1949

Correspondence regarding this well should be addressed to R. C. Cooper
 Address Cities Service Oil Company, Box 751, Great Bend, Kansas

STATE OF Kansas, COUNTY OF Rice, ss:
G. R. Smith (employee of owner) or (owner or operator) of the above-described well,

being first duly sworn on oath, says: That I have knowledge of the facts, statements, and matters herein contained and the log of the above-described well as filed and that the same are true and correct. So help me God.

(Signature) G. R. Smith
Box 505, Chase, Kansas
 (Address)

SUBSCRIBED AND SWORN TO before me this 2 day of August, 1949

Blodys Wick
 Notary Public.

My commission expires 9.25.52

PLUGGING
 FILE SEC 3 24 R/W
 BOOK PAGE 104 LINE 18

WELL RECORD

15-155-02877-0000

Company Cities Service Oil Co. Well No. 5 Farm Baughman "F"
 Location NW SW NE Sec. 3 T. 24 R. 4W
 Elevation 1168 County Reno State Kansas
 Drlg. Comm. November 2, 1935 Contractor Dickey Oil Company
 Drlg. Comp. January 16, 1936 Acid 1000 gals. 3-27-36
 T. D. 3370' Initial Prod. 433 oil, 75 water, 24 hrs; 500 MCF gas.

CASING RECORD:

16" OD @ 169' cen. 165 sacks
 10-3/4" @ 502' cen. 175 sacks
 7" @ 3313' cen. 150 sacks

FORMATION RECORD:

sand 150
 shale & shells 345
 shale & lime 498
 lime 723
 lime & shale 605
 shale & shells 880
 lime 900
 broken lime 925
 lime 1015
 shale & shells 1070
 red bed 1090
 broken lime 1150
 shale & shells 1200
 lime shells 1230
 shale 1270
 lime 1289
 shale & lime shells 1550
 shale 1632
 lime & shale 1710
 shale & shells 1810
 lime shells 1860
 lime 1885
 shale 1891
 broken lime 1975
 shale & shells 2020
 lime 2085
 shale & lime 2188
 lime 2275
 shale & lime 2358
 lime hard 2378
 lime 2450
 sticky shale 2470
 sandy shale 2510
 lime 2550
 lime shale 2568
 lime 2669

shale lime 2698
 lime 2880
 shale 2914
 red rock 2924
 lime 2939
 shale lime 2995
 shale & shells 3014
 sticky shale 3040
 lime & shale 3088
 lime 3108
 shale 3155
 shale lime 3188
 colored lime shells 3213
 shale & shells colored 3244
 colored shale 3263
 shale 3265
 chat 3370 T. D.

Top Mississippi 3255'
 Penetration 115'
 Total Depth 3370'

Oil and gas 3342-45.

RECEIVED

Oil Div.
 JUL - 8 1949
 REGISTRATION
 COMMISSION
 KANSAS

PLUGGING
 FILE NO. 3 T 24 R 4W
 BOOK PAGE 104 LINE 18