


STATE OF KANSAS  
STATE CORPORATION COMMISSION

WELL PLUGGING RECORD

Give All Information Completely  
Make Required Affidavit  
Mail or Deliver Report to:  
Conservation Division  
State Corporation Commission  
212 North Market, Insurance Bldg.  
Wichita, Kansas

Stafford County. Sec. 33 Twp. 24 Rge. 14W (E) (W)  
Location as "NE/CNWxSWx" or footage from lines SW/NW/SW  
Lease Owner Bankoff Oil Company,  
Lease Name Waters Well No. #1  
Office Address 1312 Eisenhower Street, Great Bend, Kansas  
Character of Well (completed as Oil, Gas or Dry Hole) \_\_\_\_\_  
Date well completed \_\_\_\_\_ 19\_\_\_\_  
Application for plugging filed Yes 19\_\_\_\_  
Application for plugging approved Yes 19\_\_\_\_  
Plugging commenced \_\_\_\_\_ 5-28 19 59  
Plugging completed \_\_\_\_\_ 6-11 19 59  
Reason for abandonment of well or producing formation \_\_\_\_\_

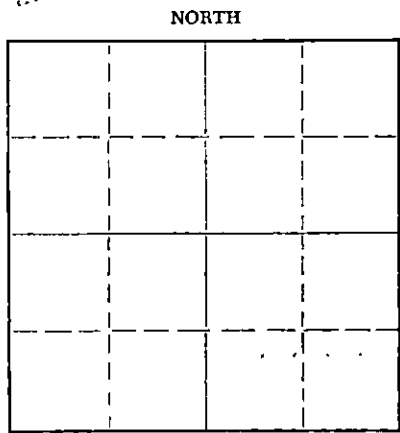

Locate well correctly on above  
Section Flat

If a producing well is abandoned, date of last production \_\_\_\_\_ 19\_\_\_\_  
Was permission obtained from the Conservation Division or its agents before plugging was commenced? Yes

Name of Conservation Agent who supervised plugging of this well Mr. Frank Broadfoot  
Producing formation \_\_\_\_\_ Depth to top \_\_\_\_\_ Bottom \_\_\_\_\_ Total Depth of Well 4315' Feet  
Show depth and thickness of all water, oil and gas formations.

OIL, GAS OR WATER RECORDS

CASING RECORD

FORMATION	CONTENT	FROM	TO	SIZE	PUT IN	PULLED OUT
				8 5/8"	surface	
				5 1/2"		2,099'

Describe in detail the manner in which the well was plugged, indicating where the mud fluid was placed and the method or methods used in introducing it into the hole. If cement or other plugs were used, state the character of same and depth placed, from \_\_\_\_\_ feet to \_\_\_\_\_ feet for each plug set.

Measured into T.D. 4315'.  
Plugging started 5-28-59. Finished 6-11-59.  
Plugged off bottom and sanded from 4315' to 4200'. Dumped 5 sacks of cement. Worked and shot pipe. Circulated and spotted 76 bbls of oil. Worked and shot pipe. Shot 5 1/2" casing at 2,099'. Pulled pipe out of hole and plugged well. Set rock bridge at 250' and dumped 10 sacks of cement. Bailed hole and checked water. Dumped 10 sacks of cement at 230'. Mudded hole to 35'. Set rock bridge and mixed 10 sacks of cement for cap on well. Well completed.

6-25-58  
RECEIVED  
STATE CORPORATION COMMISSION  
JUN 25 1959  
CONSERVATION DIVISION  
Wichita, Kansas

(If additional description is necessary, use BACK of this sheet)  
Name of Plugging Contractor J.O. Forbes d/b/a Forbes Casing Pulling Co.  
Address Box 221, Great Bend, Kansas

STATE OF Kansas COUNTY OF Barton, ss.  
J.O. Forbes (employee of owner) or (owner or operator) of the above-described well, being first duly sworn on oath, says: That I have knowledge of the facts, statements, and matters herein contained and the log of the above-described well as filed and that the same are true and correct. So help me God.

(Signature) J.O. Forbes  
Betty S. Edman (Address)

SUBSCRIBED AND SWORN to before me this 17th day of June, 1959

My commission expires November 8, 1960.  
Betty S. Edman Notary Public.

PLUGGING  
FILE SEC 33 T. 24 R. 14W  
BOOK PAGE 40 LINE 43

*See page 3*

*Bankoff Oil Co,  
Fred Harris*

WELL LOG

15-185-00479-0000

No. 1 waters

Elevations: 1985 BR  
1983 MID  
1982 RD

Chief Drilling Co. - Survey - Bankoff  
Box 97  
Great Bend, Kansas

Commenced: 5-9-58  
Completed: 5-22-58

No. 1 waters  
SW 1/4 Sec. 33 - 24 - 14W  
Stafford County, Kansas

Contractors: Chief Drilling Co., Inc.  
Rotary: 0 - 4315'

Casing Record: Set 2355' of 3 5/8" casing w/250 sacks Formix cement, Cement circulated to surface.

Set 4210' of 3 1/2", 14 lb., J-55 Smln. casing with 100 sacks Common Cement.

Figures Indicate Bottom of  
Formation

FORMATION TOPS & FEET

Sand & Clay	0 - 249
Shale & Red Bed	249 - 400
Shale & Sand	400 - 510
Shale & Shells	510 - 600
Shale & Sand	600 - 640
Shale	640 - 905
Anhydrite	905 - 920
Shale	920 - 1065
Shale & Shells	1065 - 1850
Lime & Shale	1850 - 2105
Lime	2105 - 2255
Lime & Shale	2255 - 2570
Shale & Shells	2570 - 2900
Lime & Shale	2900 - 3746
Lime	3746 - 3905
Broken Lime & Shale	3905 - 4079
Chert	4079 - 4123
Shale	4123 - 4155
Sand	4155 - 4166
Shale	4166 - 4176
Chert & Lime	4176 - 4245
Shale & Shaley Sand	4245 - 4298
Dolomite	4298 - 4315
Total Depth	4315

Anhydrite	905 (-41083)
Heebner	1535 (-1347)
Brown Line	3677 (-1659)
Lansing-ALL	3706 (-1710)
Sum K.C.	3983 (-1995)
Mississippi	4079 (-2091)
Kindernock	4123 (-2135)
Viola	4176 (-2188)
Hansen	4245 (-2257)
Arbuckle	4298 (-2310)

RECEIVED  
STATE OF KANSAS GEOLOGICAL COMMISSION  
MAY 28 1958  
REGISTRATION DIVISION  
Wichita, Kansas

State of Kansas )  
County of Barton )

I hereby certify that the above is a true and correct copy of Driller's Log of well drilled in the SW 1/4 Sec. 33-24-14W, Stafford County, Kansas, to the best of my knowledge and belief.

CHIEF DRILLING CO., INC.

*V. Richard Hoover*  
V. Richard Hoover, President

Subscribed to and sworn to before me this 27th day of May, 1958

*Wm. Richard Hoover*  
Notary Public

My Commission expires:  
Jan 26 1959

*Was deepened at 3800' - with 50  
Sacks -*

PLUGGING  
FILE SEC 33 T 24 R 14W  
BOOK PAGE 40 LINE 43