


STATE OF KANSAS
STATE CORPORATION COMMISSION

WELL PLUGGING RECORD

Give All Information Completely
Make Required Affidavit
Mail or Deliver Report to
Conservation Division
State Corporation Comm.
245 North Water
Wichita, KS 67202

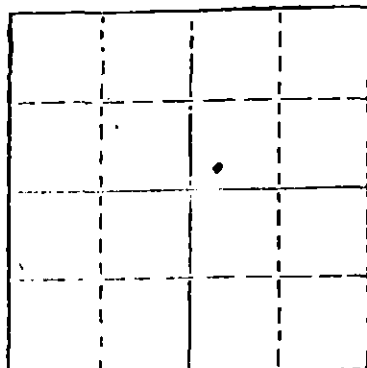

Locate well correctly on above
Section Plot

Stafford County. Sec. 33 Twp. 24S Rge. 14W E/W
Location as "NE/CNW $\frac{1}{4}$ SW $\frac{1}{4}$ " or footage from lines

SW SW NE
Lease Owner Big J. Production
Lease Name H. J. Waters Well No. 2
Office Address 427 North St. Francis Wichita, Kansas 67202
Character of Well (Completed as Oil, Gas or Dry Hole) Dry Hole

Date Well completed 1-24-81 19
Application for plugging filed 1-24-81 19
Application for plugging approved 1-24-81 19
Plugging commenced 1-24-81 19
Plugging completed 1-24-81 19
Reason for abandonment of well or producing formation

If a producing well is abandoned, date of last production 19

Was permission obtained from the Conservation Division or its agents before plugging was commenced? Yes

Name of Conservation Agent who supervised plugging of this well Duane L. Bankin
Producing formation Depth to top Bottom Total Depth of Well 4330'
Show depth and thickness of all water, oil and gas formations.

OIL, GAS OR WATER RECORDS

CASING RECORD

FORMATION	CONTENT	FROM	TO	SIZE	PUT IN	PULLED OUT

Describe in detail the manner in which the well was plugged, indicating where the mud fluid was placed and the method or methods used in introducing it into the hold. If cement or other plugs were used, state the character of same and depth placed, from feet to feet for each plug set.

Mud To 540' 50 Sacks 50-50 Posmix 4% Gel
Mud To 300' 40 Sacks 50-50 Posmix 4% Gel
Mud To 40' 10 Sacks 50-50 Posmix 4% Gel
Rat Hole 5 Sacks
Mouse Hole 5 Sacks

1-28-81

RECEIVED

(If additional description is necessary, use BACK of this sheet)

Name of Plugging Contractor Merckle Drilling Co.

JAN 28 1981

STATE OF Kansas COUNTY OF Stafford CONSERVATION DIVISION, ss.
Clyde Merckle (employee of owner) or (owner or operator)
of the above-described well, being first duly sworn on oath, says: That I have knowledge of the facts, statements, and matters herein contained and the log of the above-described well as filed and that the same are true and correct. So help me God.

(Signature)

Box 1382 Great Bend, Kansas

(Address)

SUBSCRIBED AND SWORN TO before me this 27th day of January, 1981

Louise Gandy
Notary Public.

My commission expires 3-28-84



Big J. Production
427 North St. Francis
Wichita, Kansas 67202

H. J. Waters #2

SW SW NE

Section 33 Twp 24S Rge. 14W

Stafford County

Driller's Log _____ Total Depth 4330'

6-----150 Sand

150---893 Shale

893---904 Anhydrite

904---1820 Shale

1820---2420 Shale & Lime

2420---3170 Lime & Shale

3170---3705 Lime & Shale

3705---3848 Lime

3848---4079 Lime

4079---4330 Lime


Clyde Merckle