


STATE OF KANSAS  
STATE CORPORATION COMMISSION

WELL PLUGGING RECORD

Give All Information Completely  
Make Required Affidavit  
Mail or Deliver Report to:  
Conservation Division  
State Corporation Commission  
800 Biting Building  
Wichita, Kansas

Stafford County, Sec. 27 Twp. 24 Rge. 12 (E) (W)  
Location as "NE/CNW/SW" or footage from lines NE SW SW  
Lease Owner Sun Oil Company  
Lease Name Budde Well No. 4  
Office Address Box 1348, Tulsa, Okla.  
Character of Well (completed as Oil, Gas or Dry Hole) Dryhole  
Date well completed 8-15- 1954  
Application for plugging filed 8-20- 1954  
Application for plugging approved by Telephone 8-15- 1954  
Plugging commenced 8-15- 1954  
Plugging completed 8-15- 1954  
Reason for abandonment of well or producing formation dryhole - no oil

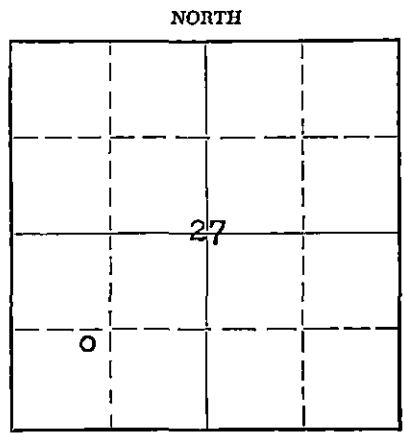

Locate well correctly on above  
Section Plat

If a producing well is abandoned, date of last production \_\_\_\_\_ 19\_\_\_\_  
Was permission obtained from the Conservation Division or its agents before plugging was commenced? Yes

Name of Conservation Agent who supervised plugging of this well M. A. Rives, Box 8, Pratt, Kans.  
Producing formation none Depth to top \_\_\_\_\_ Bottom \_\_\_\_\_ Total Depth of Well 4079 Feet  
Show depth and thickness of all water, oil and gas formations.

OIL, GAS OR WATER RECORDS

CASING RECORD

FORMATION	CONTENT	FROM	TO	SIZE	PUT IN	PULLED OUT
4065-4079' (Simpson)	water					

Describe in detail the manner in which the well was plugged, indicating where the mud fluid was placed and the method or methods used in introducing it into the hole. If cement or other plugs were used, state the character of same and depth placed, from \_\_\_\_\_ feet to \_\_\_\_\_ feet for each plug set.

Hole filled w/mud to 335' from surface.  
Pushed wooden plug to 335', followed by 1/2 sack cotten seed hulls and 20 sacks cement.  
Filled hole w/mud to 40' from surface.  
Pushed wooden plug to 40' followed by 1/2 sack hulls and 15 sax cement.

(If additional description is necessary, use BACK of this sheet)

Name of Plugging Contractor Anschutz Drilling Co.  
Address 709-10 Union Nat'l. Bank Bldg., Wichita, Kans.

STATE OF OKLAHOMA, COUNTY OF TULSA, ss.  
\_\_\_\_\_  
(employee of owner) or (owner or operator) of the above-described well, being first duly sworn on oath, says: That I have knowledge of the facts, statements, and matters herein contained and the log of the above-described well as filed and that the same are true and correct. So help me God.

(Signature) J. Hallen

SUBSCRIBED AND SWORN TO before me this 23<sup>rd</sup> day of August, 1954

Mildred Watters  
Notary Public.

My Commission Expires March 14, 1957  
My commission expires \_\_\_\_\_

CONSERVATION DIVISION

8-24-54

PLUGGING  
FILE SEC 27 at 8/20  
BOOK PAGE 57 LINE 13

DRILLERS' LOG

SUN OIL COMPANY  
 Budde No. 4  
 NE/4 SW/4 SW/4  
 Sec. 27, Twp. 24S, Rge. 12W  
 Stafford County, Kansas

=====

<u>FORMATION</u>	<u>FROM</u>	<u>TO</u>	Elev. DF 1879'
Sand & shale	0	180	Drilling Commenced: 7-29-54
Shale w/ls. strks.	180	347	Drilling Completed: 8-15-54
Shale & shells	347	675	
Anhydrite	675	710	
	710	1190	<u>CASING RECORD</u>
	1190	1810	8-5/8" 32# SS casing set at 339', cemented w/300 sacks
	1810	3015	
	3015	3215	<u>CORE RECORD</u>
	3215	3385	Core #1: 4065'-4079' rec. 11' shale, 1' sdy. shale, 1' sand (bleeding)
	3385	3520	
	3520	3850	<u>DRILL STEM TEST</u>
	3850	3926	T.D. 4079', packer at 4067', open 1 hr., rec. 370' gas cut salt water.
	3926	4057	
	4057	4078	
	4078	4079	
		T.D.	

RECEIVED  
 STATE CONSERVATION COMMISSION  
 AUG 24 1954  
 CONSERVATION DIVISION  
 Wichita, Kansas

I hereby certify that the foregoing is a true and correct copy of the Budde No. 4 well log as recorded on the books of Sun Oil Company, Tulsa, Oklahoma.

J. H. Allen  
 J. H. Allen

STATE OF OKLAHOMA )  
 ) SS  
 COUNTY OF TULSA )

Subscribed and sworn to before me this 23<sup>rd</sup> day of August, 1954.

Mildred Watters

My Commission Expires:  
 My Commission Expires March 14, 1957

**PLUGGING**  
 FILE SEC 27, 24 R 12W  
 BOOK PAGE 57 LINE 13