


STATE OF KANSAS  
STATE CORPORATION COMMISSION

Form CP-4

WELL PLUGGING RECORD

Give All Information Completely  
Make Required Affidavit  
Mail or Deliver Report to:  
Conservation Division  
State Corporation Commission  
212 No. Market  
Wichita, Kansas

NORTH

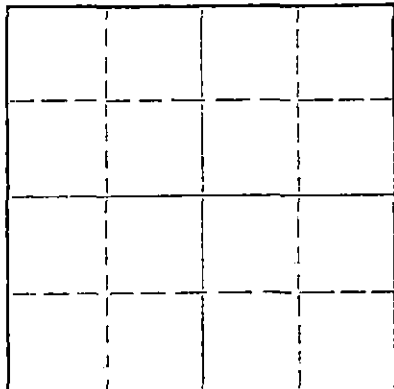

Locate well correctly on above  
Section Plat

STAFFORD County. Sec. 27 Twp. 24 Rge. 12 (E) (W)  
Location as "NE/CNW/SW" or footage from lines C SW - SW - NE  
Lease Owner Misco Supply Company  
Lease Name J. W. JENKINS Well No. 1  
Office Address 200 Misco Bldg., Wichita, Kansas  
Character of Well (completed as Oil, Gas or Dry Hole)  
Date well completed 19  
Application for plugging filed 19  
Application for plugging approved 19  
Plugging commenced 8-5 1967  
Plugging completed 8-8 1967  
Reason for abandonment of well or producing formation

If a producing well is abandoned, date of last production 19  
Was permission obtained from the Conservation Division or its agents before plugging was commenced? YES

Name of Conservation Agent who supervised plugging of this well ARCHIE ELVING  
Producing formation Depth to top Bottom Total Depth of Well 4072 Feet  
Show depth and thickness of all water, oil and gas formations.

OIL, GAS OR WATER RECORDS

CASING RECORD

FORMATION	CONTENT	FRDM	TO	SIZE	PUT IN	PULLED OUT
				8 5/8	675	NONE
				5 1/2	3924	1827

Describe in detail the manner in which the well was plugged, indicating where the mud fluid was placed and the method or methods used in introducing it into the hole. If cement or other plugs were used, state the character of same and depth placed, from feet to feet for each plug set.

PULL 1827 FT. 5 1/2" PIPE - MUD HOLE TO 360 FT. - 10 FT. ROCK BRIDGE TO 350 FT. - DUMP 5 YDS. READY MIX CEMENT TO SURFACE.

STAMP: CONSERVATION DIVISION, WICHITA, KANSAS, 10-2-67

(If additional description is necessary, use BACK of this sheet)

Name of Plugging Contractor RALPH COMSTOCK PIPE PULLING - PERMIT # 490  
Address STAFFORD, KANSAS

STATE OF KANSAS, COUNTY OF STAFFORD, ss.  
(employee of owner) or (owner or operator) of the above-described well, being first duly sworn on oath, says: That I have knowledge of the facts, statements, and matters herein contained and the log of the above-described well as filed and that the same are true and correct. So help me God.

(Signature) Ralph Comstock  
Stafford, Kansas (Address)

SWORN to before me this 28th day of September, 1967  
My commission expires Feb. 5, 1971



Lawrence C. Richardson  
Notary Public.

DRILLER'S LOG

Company: , Gulf Oil Corp.

Sec. 27 Twp. 245 Rge. 12W  
CSW SW NE

Farm: J. W. Jenkins Well No. 1

County: Stafford  
Kansas

Total Depth: 3929' (Rotary)  
Comm.: 6-4-52 Comp.: 6-17-52  
Contractor: Glenn W. Peel

Elevation:  
Production:

Ca  
Casing: 8 5/8" 675' Cem.  
5 1/2" 3924' Cem.

Figures below indicate bottom of formations

Surface Clay and Sand	0 -	140
Shale and Sand		210
Shale and Shells		595
Red bed and Shells		668
Anhydrite		695
Shale and Shells		2050
Shale and Lime		2350
Lime		2445
Lime with Shale Streaks		3195
Lime		3360
Lime and Shale		3465
Lime		3929
Total Depth		3929

*Deepened with cable tools to 4078'*  
This is to certify that the above information is, to the best of our knowledge, true and correct.

GLENN W. PEEL

By: *[Signature]*

SUBSCRIBED AND SWORN TO BEFORE me this 1st day of July, 1952

My commission expires June 4, 1955 *Marian M. Hester*  
Notary Public

RECEIVED  
STATE CORPORATION COMMISSION  
JUL 13 1967  
CONSERVATION DIVISION  
Wichita, Kansas