

CARD MUST BE TYPED

State of Kansas  
NOTICE OF INTENTION TO DRILL

CARD MUST BE SIGNED

(see rules on reverse side)

Starting Date: 8 / 08 / 1984  
month day year

API Number 15- 095-21,481-0000

OPERATOR: License # 5606  
Name: R. J. WALKER OIL Co., INC.  
Address: 1000 Nat Found Life Bldg.  
City/State/Zip: 3535 NW 58th Okla. City, OK  
Contact Person: O. N. Goode 73112  
Phone: (405) 949-2440

SE., SE., NE Sec .18. Twp .29 S, Rge .5. ~~XX~~ West  
(location)  
2970 Ft North from Southeast Corner of Section  
330 Ft West from Southeast Corner of Section  
(Note: Locate well on Section Plat on reverse side)

CONTRACTOR: License # 5133  
Name: Kansas Drilling & Well Service  
City/State: Marion, Kansas Inc.

Nearest lease or unit boundary line 990 feet.  
County Kingman  
Lease Name R. Kincaid et al Well# 1-18  
Domestic well within 330 feet:  yes  no  
Municipal well within one mile:  yes  no

Well Drilled For: Well Class: Type Equipment:  
 Oil  Swd  Infield  Mud Rotary  
 Gas  Inj  Pool Ext.  Air Rotary  
 OWWO  Expl  Wildcat  Cable

Depth to Bottom of fresh water 50 feet  
Lowest usable water formation Permian  
Depth to Bottom of usable water 200 feet  
Surface pipe by Alternate: 1  2   
Surface pipe to be set 200+ feet  
Conductor pipe if any required None feet  
Ground surface elevation 1510 feet MSL  
This Authorization Expires 2-6-85  
Approved By 8/6/84

If OWWO: old well info as follows:

Operator  
Well Name  
Comp Date Old Total Depth  
Projected Total Depth 4600 feet  
Projected Formation at TD Simpson  
Expected Producing Formations Penn, Viola, Simpson

I certify that we will comply with K.S.A. 55-101, et seq., plus eventually plugging hole to K.C.C. specifications.

Date 7/25/84 Signature of Operator or Agent O. N. Goode Title Engr.


mhc/KONE 8/6/84 Form C-1 4/84

Must be filed with the K.C.C. five (5) days prior to commencing well  
 This card void if drilling not started within six (6) months of date received by K.C.C.

**Important procedures to follow:**

1. Notify District office before setting surface casing.
2. Set surface casing by circulating cement to the top.
3. File completion forms ACO-1 with K.C.C. within 90 days of well completion, following instructions on ACO-1, side 1, and including copies of wireline logs.
4. Notify District office 48 hours prior to old well workover or re-entry.
5. Prior to plugging, prepare a plugging plan, then obtain agreement from the appropriate district office for an approved plugging plan.
6. Submit plugging report (CP-4) to K.C.C. after plugging is completed.
7. Obtain an approved injection docket number before disposing of salt water.
8. Notify K.C.C. within 10 days when injection commences or terminates.
9. If an alternate 2 completion, cement in the production pipe from the first usable water to surface within 120 days of spud date.

**A Regular Section of Land**  
 1 Mile = 5,280 Ft.

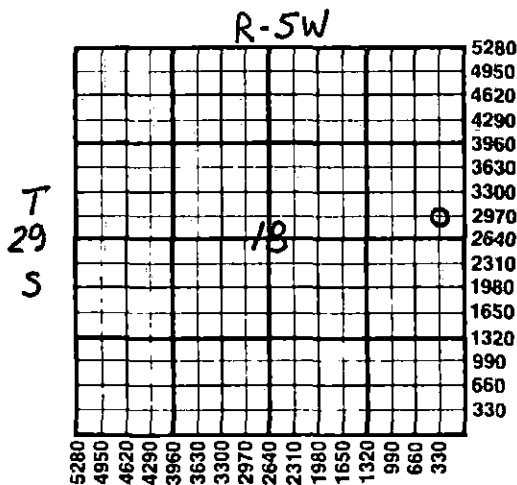

R. J. WALKER OIL Co., Inc.  
 R. Kincaid et al #1-18

State Corporation Commission of Kansas  
 Conservation Division  
 200 Colorado Derby Building  
 Wichita, Kansas 67202  
 (316) 263-3238

RECEIVED  
 STATE CORPORATION COMMISSION

JUL 27 1984

CONSERVATION DIVISION  
 Wichita, Kansas